




# P&A Wellbore For State

Well Name: CECIL 32-32

Land, Original Hole, 10/17/2023 8:32:41 AM

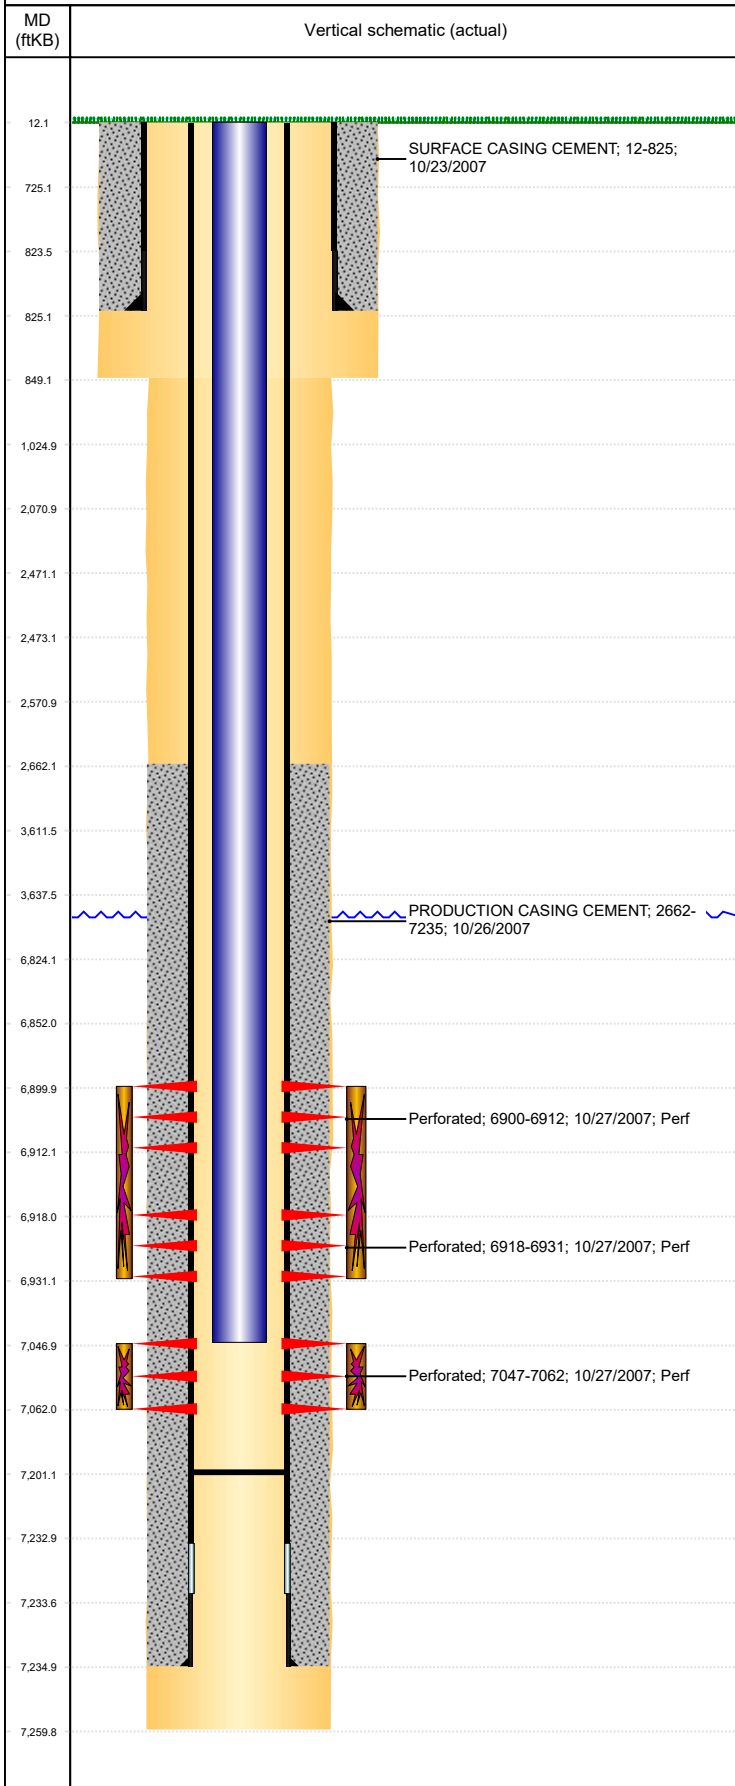

Well Header									
Surface UWI 0512323810			Business Unit Rockies			Gov Auth Dist		Prod Tree Loc Land	
Orig. KB to Gnd (ft) 12.00		Original Spud Date 10/23/2007		Abandon Date		Well Sub-Status PR			High... N
Comment									
Surface Location (Congressional)									
Qtr 3 NW	Qtr 4 SW	Section 32	Twnshp 7	Twnsh... N	Range 64	Rng E/... W	Latitude (°) 40.52722	Longitude (°) -104.58	
Wellbore Sections									
Section Des			Hole Size (in)			Act Top (ftKB)		Act Btm (ftKB)	
SURFACE			12 1/4			12.0		849.0	
PRODUCTION			7 7/8			849.0		7,260.0	
Casing Strings									
Csg Des			Run Date		OD (in)	Wt/Len (lb/ft)	Grade	Top Depth (MD) (ftKB)	Set Depth (MD) (ftKB)
Surface			10/23/2007		8 5/8	24.00		12	825
Production Casing			10/26/2007		4 1/2	11.60	LT&C	12	7235
Cement									
Des					Start Date		Top (ftKB)		Btm (ftKB)
SURFACE CASING CEMENT					10/23/2007		12.0		825.0
PRODUCTION CASING CEMENT					10/26/2007		2,662.0		7,235.0
Zone Statuses									
Zone Name		Status Date	Status	Fluid Type	Job			Prod Method	
NIOBRARA		11/29/2007	PR		DRILLING/COMPLETION - ORIGINAL, 10/23/200...			Flowing	
CODELL		12/8/2011	PR					Flowing	
CODELL		2/21/2016	PR						
Perforation Data									
Linked Zone			Explosive Type	Entered Shot Total	Top (ftKB)		Btm (ftKB)		Date
NIOBRARA, Original Hole				100	6,900.0		6,912.0		10/27/2007
NIOBRARA, Original Hole				100	6,918.0		6,931.0		10/27/2007
CODELL, Original Hole				60	7,047.0		7,062.0		10/27/2007
Stimulation Intervals									
Zone				Start Date		Top (ftKB)		Btm (ftKB)	
NIOBRARA, Original Hole				11/8/2007		6,900.0		6,931.0	
CODELL, Original Hole				11/8/2007		7,047.0		7,062.0	
Other In Hole									
Run Date		Des			Make		OD (in)	Top (ftKB)	Btm (ftKB)
4/18/2017		Stage Tool						4,274.0	4,279.0
Logs									
Date		Type					Depth Top (MD) (ftKB)		Btm (ftKB)
10/27/2007		COMPENSATED DENSITY					3,700		7,240.0
10/27/2007		INDUCTION					825		7,260.0
11/2/2007		CEMENT BOND					2,500		7,199.0
Plug Back Total Depths									
Date		Type			Com				PBTD (ftKB)
10/26/2007		FLOAT COLLAR			TOP OF FLOAT COLLAR				7,222
11/2/2007		FILL			DEPTH LOGGER ON CBL				7,201