Proposed P&A WBD

Well Name: ROUSE USX A05-07

Land, Original Hole, 10/18/2023 6:37:35 AM
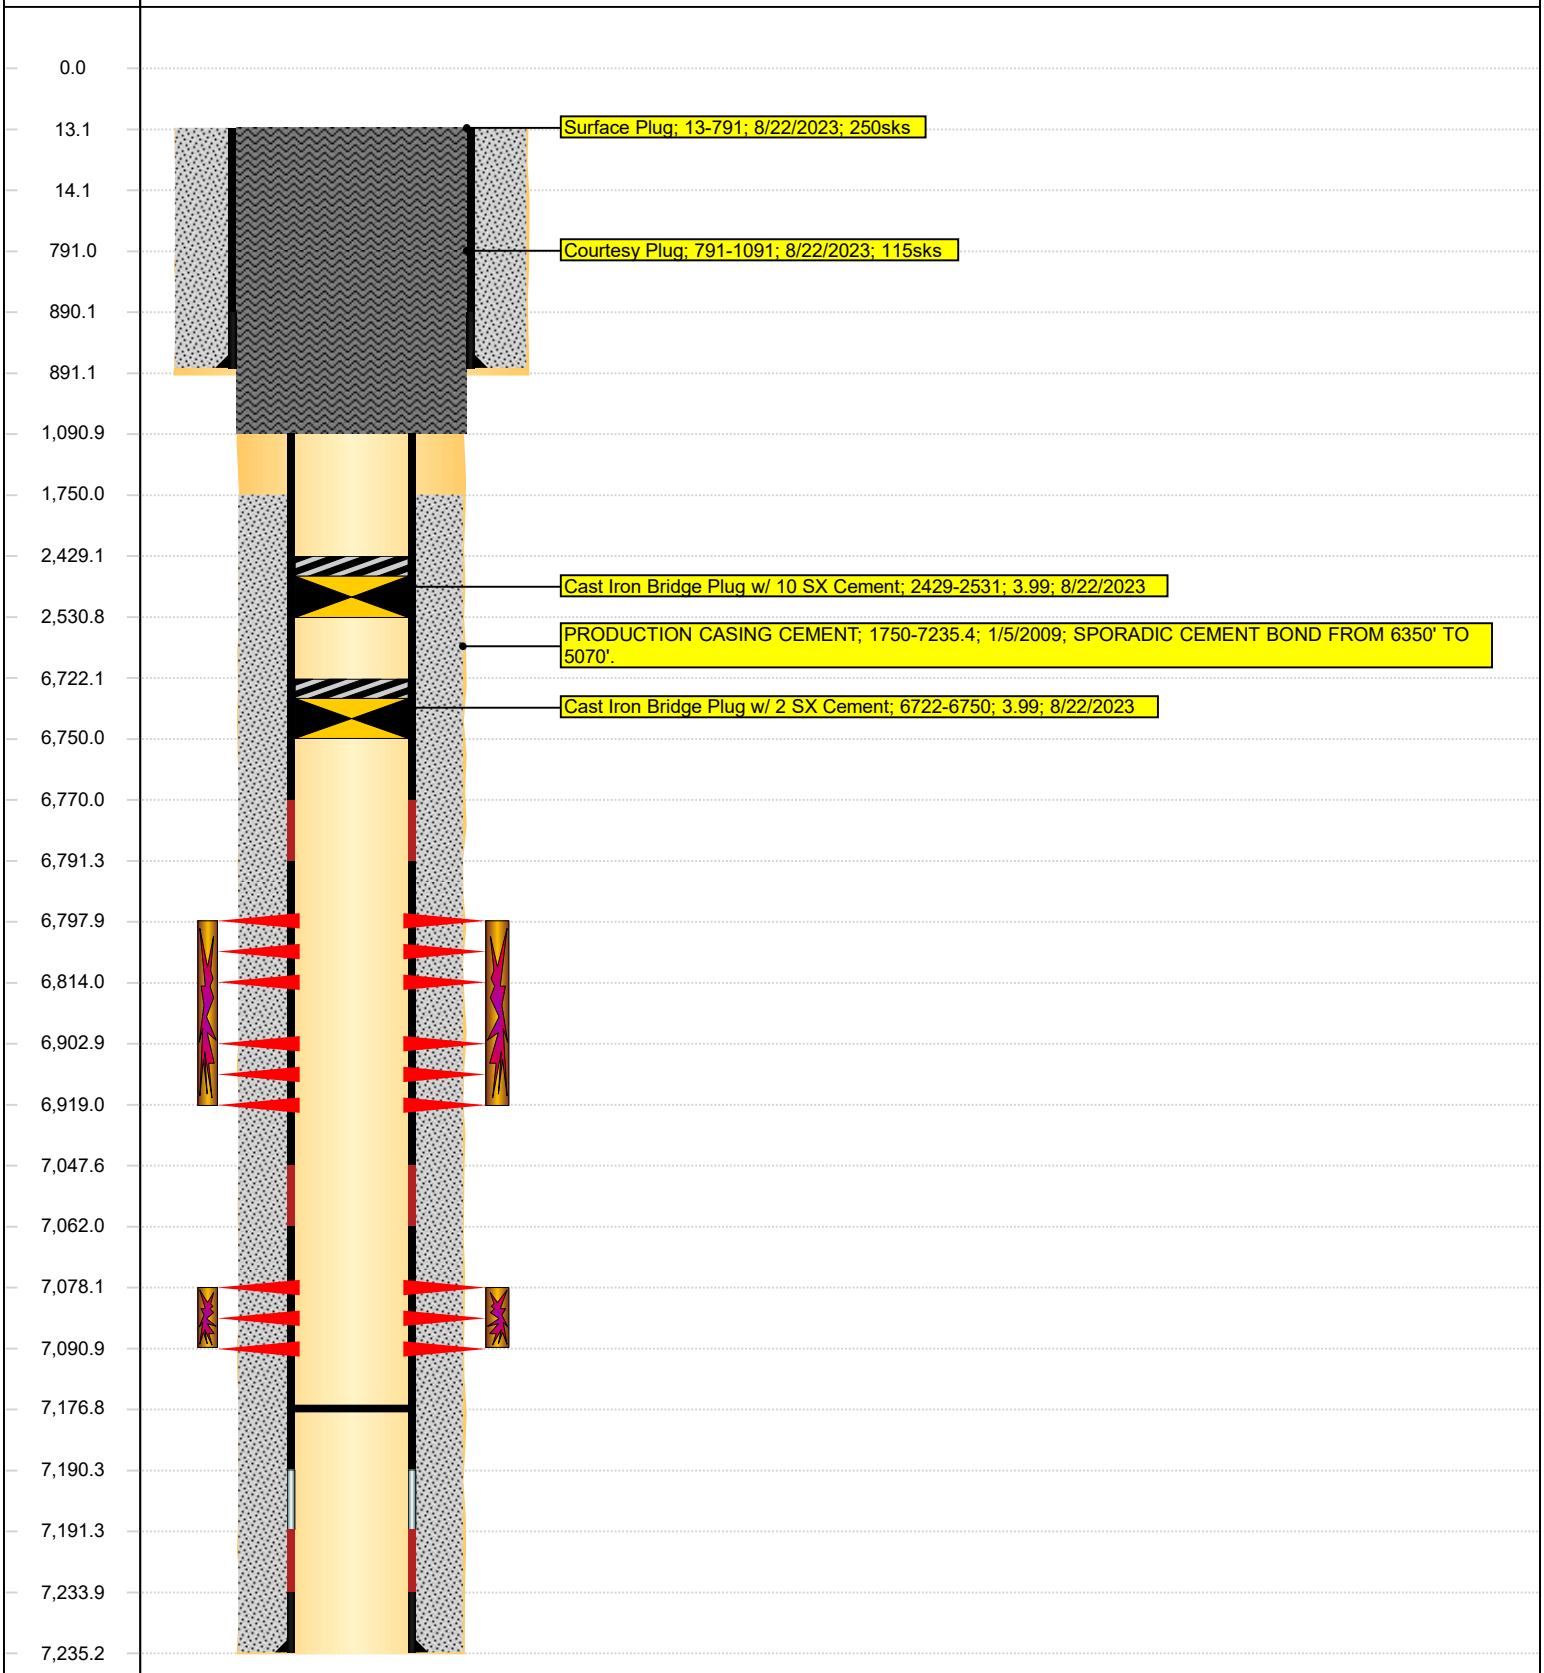
MD (ftKB)	Vertical schematic (proposed)