



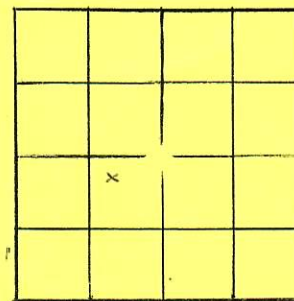
## VERBAL REQUEST

NOTICE OF INTENTION TO DRILL ✓

Bonding Status \_\_\_\_\_

NOTICE OF INTENTION TO ABANDON \_\_\_\_\_

OTHER \_\_\_\_\_

COMPANY International Nuclear ADDRESS \_\_\_\_\_BY Roger Hamer Title \_\_\_\_\_ PHONE NO. \_\_\_\_\_  
Extension \_\_\_\_\_WELL NO. 4-X LEASE LowCOUNTY Cheyenne FIELD Golden SpikeLocation 150' NW C NESW Sec. 12 Twp. 16 S Rge. 45 W Meridian \_\_\_\_\_\_\_\_\_\_ feet from \_\_\_\_\_ Section line, and \_\_\_\_\_ feet from \_\_\_\_\_ Section Line  
N or S E or WESTIMATED DATE OF WORK 8/8/69 ESTIMATED TIME \_\_\_\_\_DETAILS OF PLAN OF WORK: T.D. ±5620 FORMATION \_\_\_\_\_SURFACE CASING ±600Last hole in No. 4 Low  
Will skid rig 150' NW (150' tolerance  
in Golden Spike Order)APPROVED BY [Signature]DATE 8/8/69

✓