


T 1N, R 102W, 6th P.M.

PROJECT

GULFLAND INC.

WELL LOCATION AS SHOWN IN THE
SW 1/4 OF THE NE 1/4, SECTION 11,
T 1N, R 102 W, 6th P.M., RIO BLANCO
COUNTY, COLORADO

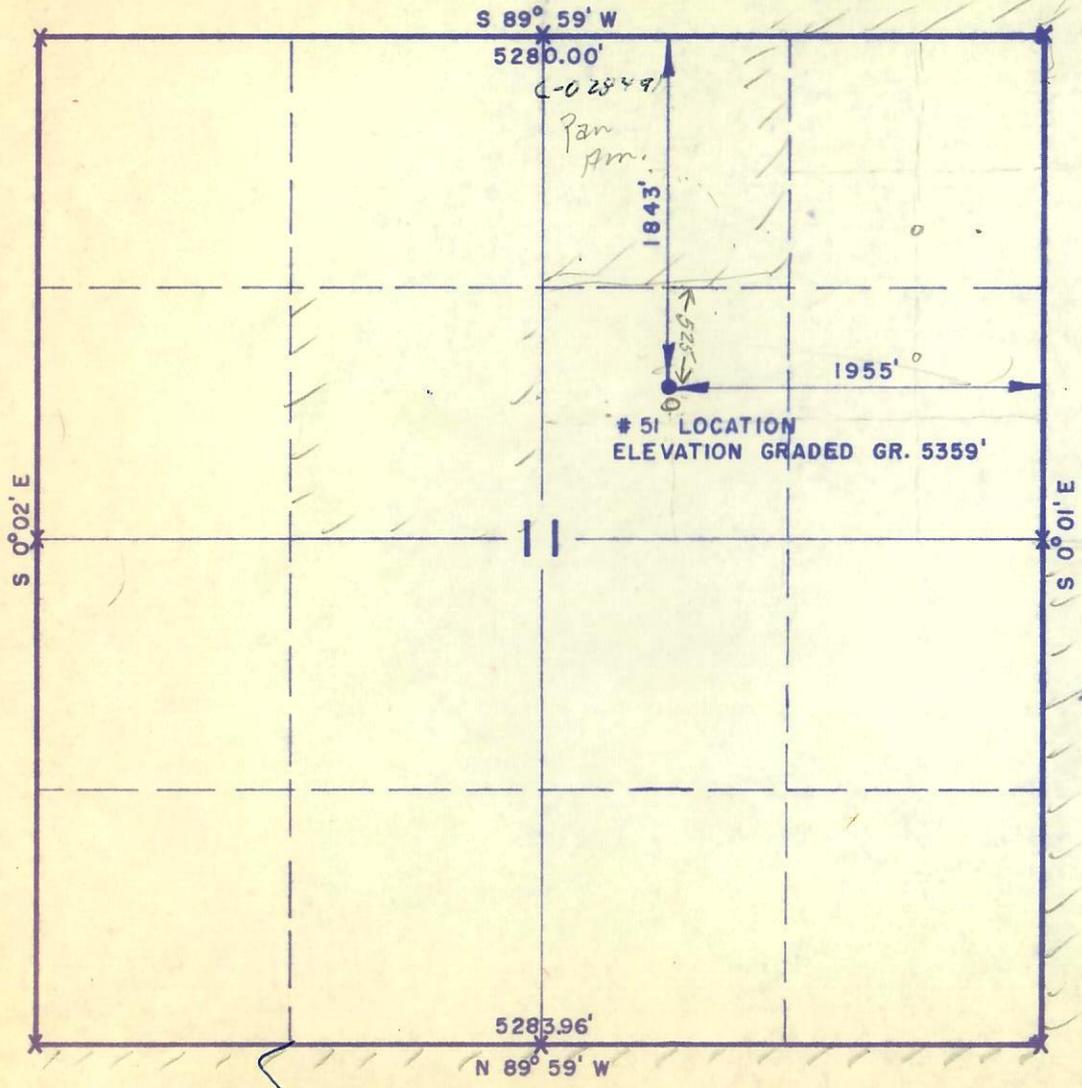

CERTIFICATE

THIS IS TO CERTIFY THAT THE ABOVE PLAT WAS PREPARED FROM
FIELD NOTES OF ACTUAL SURVEYS MADE BY ME OR UNDER MY
SUPERVISION AND THAT THE SAME ARE TRUE AND CORRECT TO THE
BEST OF MY KNOWLEDGE AND BELIEF.

Thane Stewart
REGISTERED LAND SURVEYOR
REGISTRATION NO 9186
STATE OF COLORADO

UTAH ENGINEERING & LAND SURVEYING P. O. BOX Q - 110 EAST - FIRST SOUTH VERNAL, UTAH - 84078	
SCALE	1" = 1000'
DATE	Sept. 16, 1968
PARTY	G.S., L.T.
REFERENCES	GLO Plat
WEATHER	Fair & Warm
FILE	Gulfland

X = Corners Located