

CERTIFICATE OF SURVEY
for
UP, Petroleum Inc.
Kiowa County, Colorado

RECEIVED


AUG - 5 1969

COLO. OIL & GAS CONS. COMM.



00521589

T17S R45W 6PM

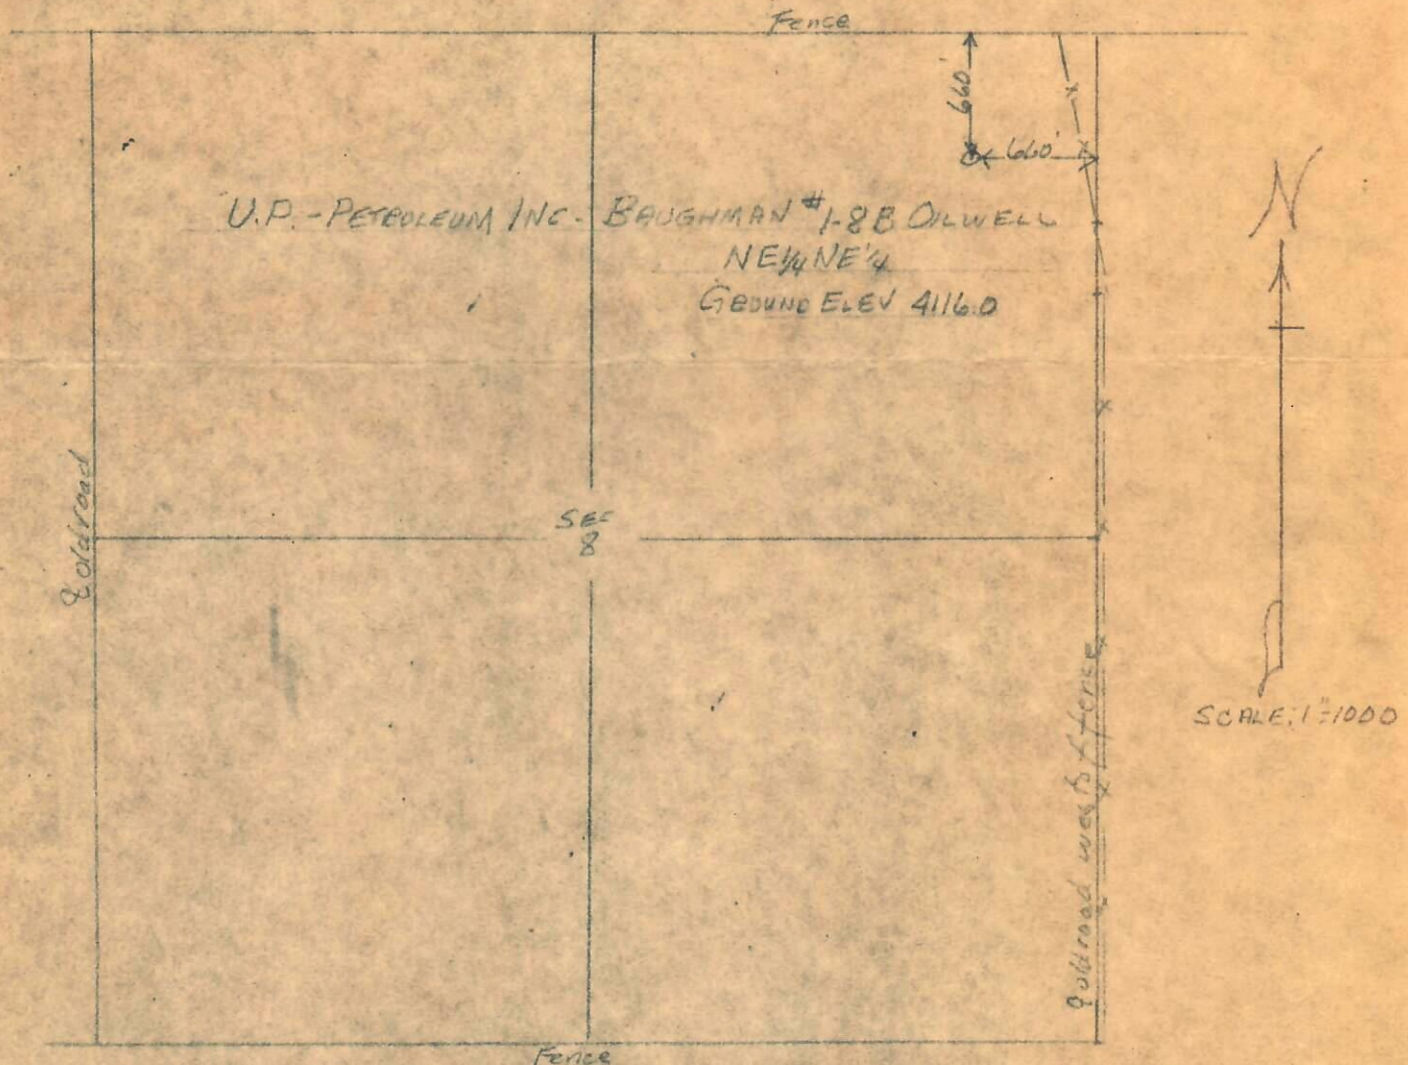

I hereby certify that the above plat is an accurate representation of a correct survey showing the location of UP, Petroleum Inc. - Baughman ~~No. 1-2B~~ Oilwell in ~~NE 1/4 NE 1/4~~ Sec. 8 T17S R45W 6PM. The elevation of the ground at the stake is 4116.0 feet above sea level from U.S.C.&G. Bench Mark. D #1

Fort Morgan, Colorado
August 3, 1969

Cecil J. Robison
Registered Professional Engineer
State of Colorado