




MAY-1 1963

OIL AND GAS CONSERVATION COMMISSION OF THE STATE OF COLORADO

NOTICE OF INTENTION TO DRILL

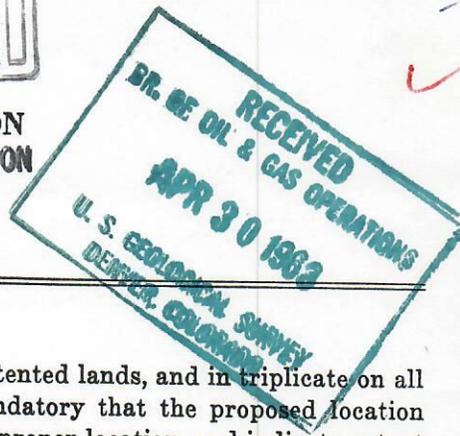


INSTRUCTIONS:

A notice of intention to drill a well shall be filed in duplicate on all Federal and Patented lands, and in triplicate on all State lands. Do not begin operations until approved copy has been received. It is mandatory that the proposed location comply with all rules and regulations of the Commission. Locate well on section grid in proper location, and indicate extent of lease. Unless operations are commenced within 180 days after the date of approval hereof, this approval to drill will become null and void.

Name of Operator R & R Well Service Co. Phone No. 675-8642 Address Box 637 City Rangely State Colorado

How is liability secured: Well Bond (Attached) []; Blanket Bond [x]; Waiver [] (Check one)

Lease Name LuBauer-Gov't Well No. 6 Field Name Rangely Wildcat [] County Rio Blanco

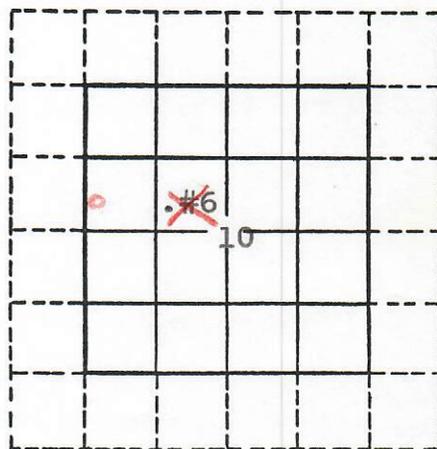

Location SW 1/4 NW 1/4 Section 10 Township 1N Range 102 W Meridian 6th P.M. 2052 1/2 feet from N Section line and 1047 feet from W Section Line

The well is located on: Patented land [] State land [] Federal land [x]

The well is located within a spaced area: Yes [] No [x]

Distance from proposed location to nearest property or lease line 500 feet. Distance from proposed location to nearest drilling unit line 4,000 feet.

Objectives: Mancos Formation Depth 3,000' Estimate; Mancos Formation Depth 3,000' Estimate

Proposed length of surface casing 40 feet.

REMARKS:

Proposed T.D. of 3,000' or commercial production at a lesser depth.

8 5/8" Surface csg. 40' to 60'

Table with columns for Agent, Date, Depth (800 ft, 1200 ft), Well, and Status. Includes handwritten notes and checkmarks.

I/We hereby swear (or affirm) that the statements herein made are a full and correct report.

APPROVED:

Date MAY 1 1963 J. W. Rogers Director

Company R & R Well Service Co. Date 4-29-63 Address Rangely, Colorado Phone No. 675-8642 By R. Redding Signature Title Co-Owner