




Proposed P&A WBD

Well Name: HOWARD USX A09-23

Land, Original Hole, 11/6/2023 8:40:47 AM

Vertical schematic (proposed)

MD (ftKB)

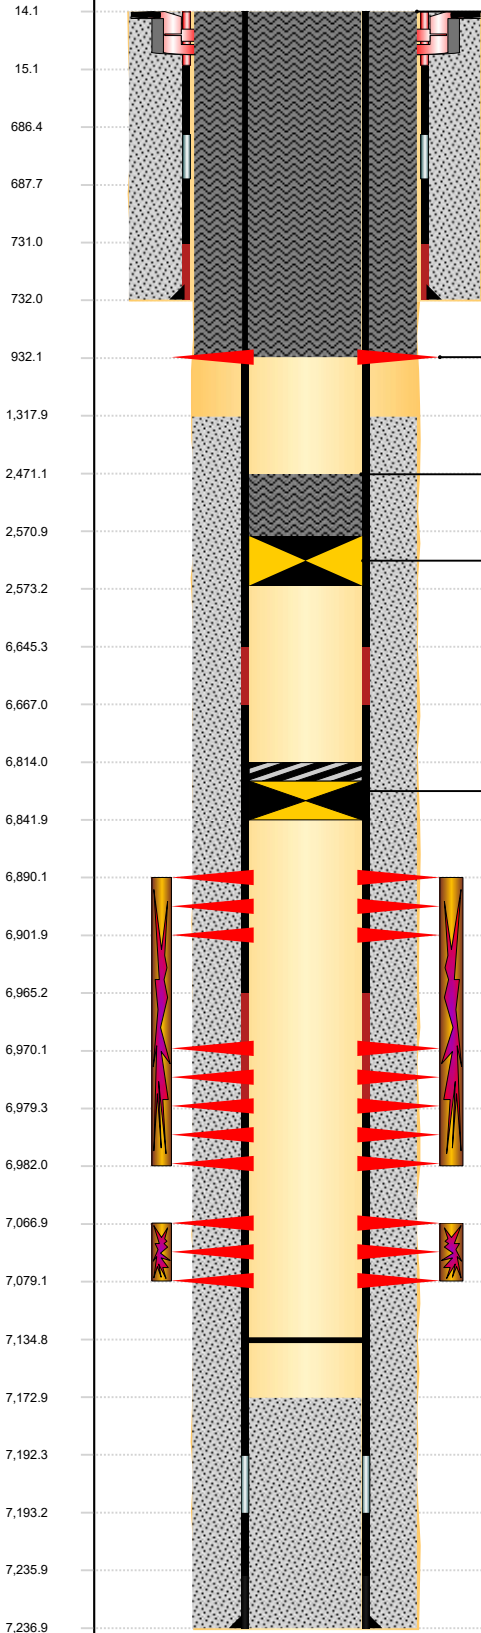

Surface Plug: 14-932; 11/2/2023; 220 sks in annulus, 75 sks in production casing, 295 sks total.

Perforated: 932-932; 11/2/2023

Courtesy Plug: 2471-2571; 11/2/2023; 10 sks

Cast Iron Bridge Plug: 2571-2573; 4; 11/2/2023

Cast Iron Bridge Plug w/ 2 SX Cement: 6814-6842; 4; 11/2/2023