



RECEIVED

FEB 4 1976

COLO. OIL & GAS CONS. COMM.

RANGE 49W



36

1


31

32

6

5

TOWNSHIP 14S

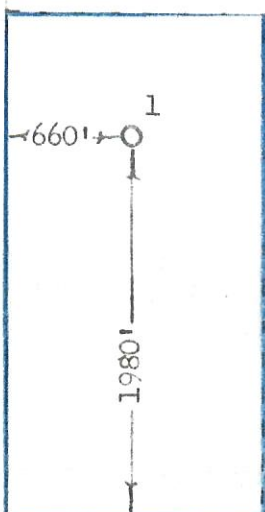

12

7

8

76 74

BARTLESVILLE, OKLAHOMA

PHILLIPS PETROLEUM COMPANY - WILKERSON "A" LEASE

80 ACRES - W/2 of SW/4, SECTION 6, TOWNSHIP 14S,
RANGE 49W, CHEYENNE COUNTY, COLORADO

DRAWN 1-26-76

DMS

AFE NO.

DWG. NO.

CHECKED

SCALE 1"=1000'

SHEET NO.

REVISION

BY

DATE

APPROVED