


RECEIVED

JUL 17 1970

COLO. OIL & GAS CONS. COMM.

R. 45W

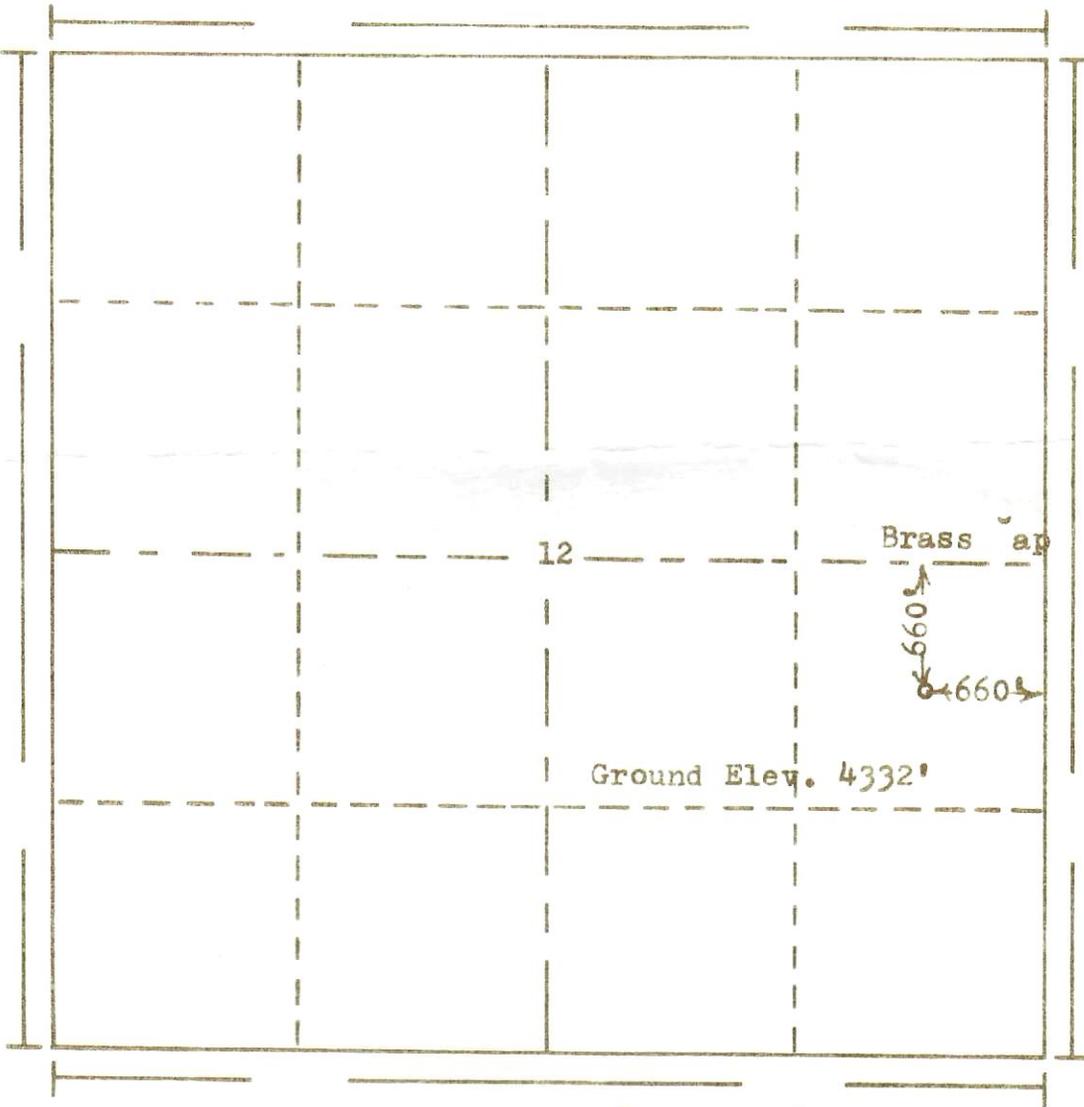

T.  
16  
S

Scale... 1" = 1000'

Powers Elevation Company, Inc. of Denver, Colorado  
 has in accordance with a request from Mr. Ham  
 for Inexco Oil Company  
 determined the location of No.2 Flowers  
 to be CNE SE Section 12 Township 16S  
 Range 45W of the 6th Principal Meridian  
Cheyenne County, Colorado

I hereby certify that this plat is an  
 accurate representation of a correct  
 survey showing the location of

Date 7-7-70

Birney G. Ham  
 Licensed Land Surveyor No. 2853  
 State of Colorado

70-295