


East Hudson B State #1-16 Existing WBD

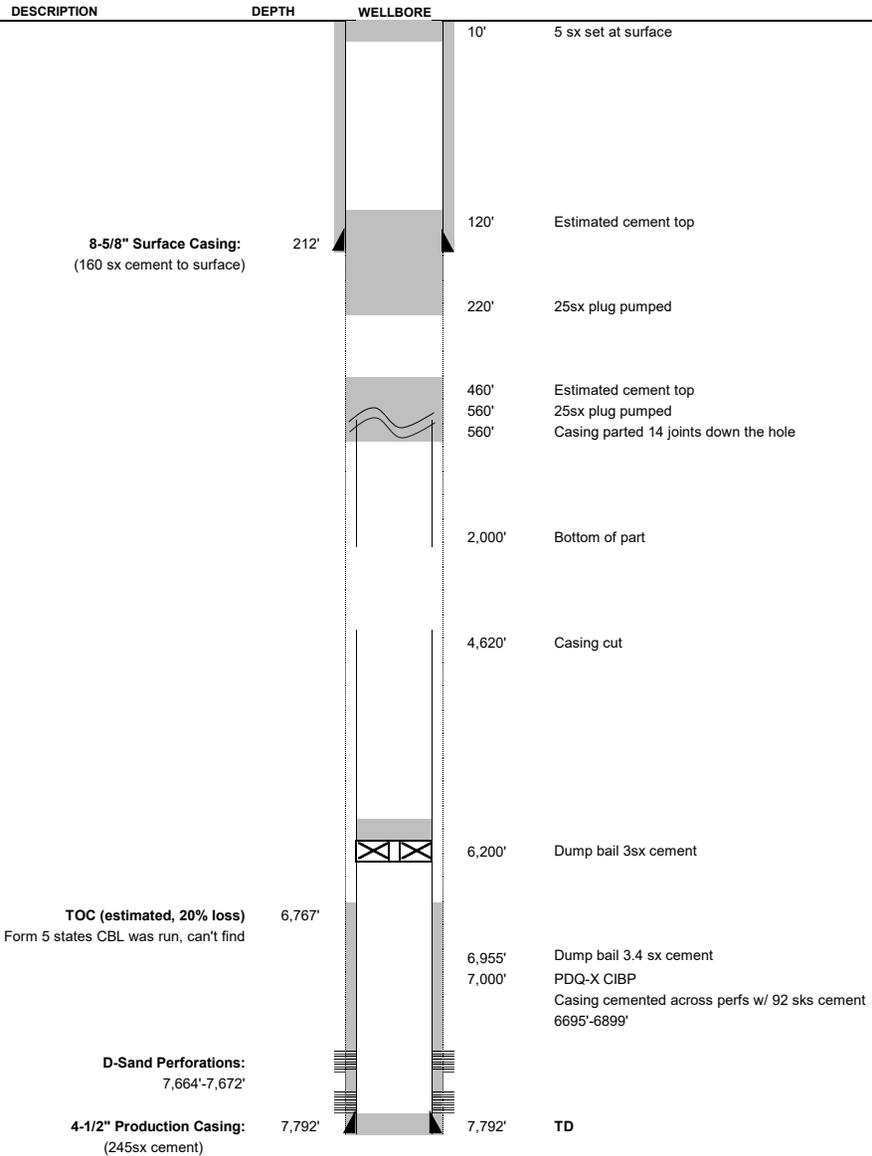

WELL: East Hudson B State #1-16

LOCATION: SWNW 16 1N 64W
1980FNL 660FWL (Planned)
40.053129 -104.563067

FORMATION: DSND 6/25/1988 **PDOP** 1.3
Date 11/2/2023

API #: 05-123-11425

Field: WATTENBERG

CURRENT STATUS: PA

Spud: 10/7/1983
P&A: 6/25/1988

Casing and Tubular Data

Type	Size	Weight	Top	Bottom	Hole Size
Surface	8 5/8"	24.0 ppf	0	212'	12-1/4"
Production	4 1/2"	11.6 ppf	0	7,792'	7-7/8"

Elevation Data

GL	5081	feet	
KB	5091	feet	Assumed
Difference	10	feet	

Formation Tops Data

Formation	Depth	
Base of Upper Arapahoe	192	MD
Base of Lower Arapahoe	481	MD
Base of Fox Hills	1,177	MD
Base of Upper Pierre	2,080	MD
Niobrara	6,954	MD
D Sand	7,663	MD
J Sand	7,724	MD