


877-8585/

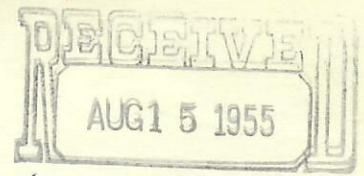

The Oakland Corporation (J.M. Goffland, Jr.)  
OIL & GAS  
CONSERVATION COMMISSION

Enterprise Unit Well #1.

Sec- 21. T-2-N- R-2-W- Ute P.M.

Mesa County Colorado -

Govt.

H. Turman

G. Goss.

G. Goss

21

I.D. Ashburn

Hoyt Norman

Howard Vincent

80 Ac -

Harold  
Mogenson.

Mike Marinelli

190.7 Ac.

- 660 - Location

K. Towsley

80 Ac -



Emery Nielson -

I.R. Billings -

This certifies that this plat is true and correct to the best of my knowledge and the work was done under my direction.

J.B. Claybaugh Engineering Co.  
By.

Registered & Licensed Engineer # 197