


Sec. 2

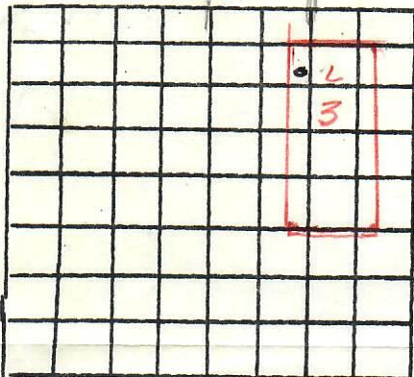

Locate
Well
Correctly

OFFICE OF STATE OIL INSPECTOR
Oil and Gas Conservation
Department

LOG OF OIL AND GAS WELL



Company _____ Address _____
State, or Patented _____ Field Kangely State Colo
Well No. 2 Sec. 2 T. 1N R. 10W Meridian 10N County Pio Blanco
(N) (E)
Location 797 Ft. (S) of N Line and 124 Ft. (W) of W line of _____ Elevation 5240
(Derrick floor relative to sea level)

The information given herewith is a complete and correct record of the well and all work done thereon so far as can be determined from all available records.

Date May 10th 1952 Signed L. E. Jones
Title _____

The summary on this page is for the condition of the well as above date.

Commenced drilling April 12, 19 _____ Finished Drilling May 3 19 52

OIL SANDS OR ZONES

No. 1, from _____ to _____ No. 4, from _____ to _____
No. 2, from _____ to _____ No. 5, from _____ to _____
No. 3, from _____ to _____ No. 6, from _____ to _____

IMPORTANT WATER SANDS

No. 1, from _____ to _____ No. 3, from _____ to _____
No. 2, from _____ to _____ No. 4, from _____ to _____

CASING RECORD

Size	Weight per ft.	Threads per inch	Make	Amount	Kind of Shoe	Cut & Pulled from	Perforated From to	Purpose
<u>8 1/4</u>	<u>36</u>	<u>8</u>		<u>41'</u>				

MUDDING AND CEMENTING RECORD

Size	Where Set	No. Sacks of Cement	Methods used	Mud Gravity	Amount of Mud Used
<u>8 1/4</u>	<u>41'</u>	<u>10</u>			

PLUGS AND ADAPTERS

Heaving plug-Material _____ Length _____ Depth Set 103 - 40212
Adapters-Material _____ Size _____

SHOOTING RECORD

Size	Shell Used	Explosive Used	Quantity	Date	Depth Shot	Depth Cleaned Out

TOOLS USED

Rotary Tools used from _____ ft. to _____ ft. and from _____ ft. to _____ ft.
Cable tools were used from _____ ft. to _____ ft. and from _____ ft. to _____ ft.

DATES

_____ 19 _____ Put to producing _____ 19 _____
The production for the first 24 hours was _____ barrels of fluid of which
% was oil, % emulsion; % sediment. Gravity Be, _____
If gas well, cu. ft. per 24 hours _____ Gallons gasoline per 1,000 cu. ft.
of gas _____ Rock Pressure, lbs. per sq. in _____

EMPLOYEES

M. F. Toles, Contractor Driller _____, Driller
Driller _____, Driller

FORMATION RECORD

From	To	Total Feet	Formation
<u>0</u>	<u>31</u>	<u>31</u>	<u>adobe & gravel</u>
<u>31</u>	<u>2000</u>	<u>1969</u>	<u>Blue shale</u>