




00566419

OIL AND GAS CONSERVATION COMMISSION OF THE STATE OF COLORADO

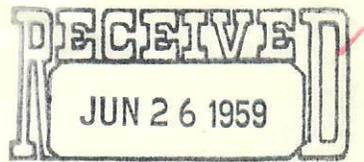

OIL & GAS CONSERVATION COMMISSION

NOTICE OF INTENTION TO DRILL


INSTRUCTIONS:

A notice of intention to drill a well shall be filed in duplicate on all Federal and Patented lands, and in triplicate on all State lands. Do not begin operations until approved copy has been received. It is mandatory that the proposed location comply with all rules and regulations of the Commission. Locate well on section grid in proper location, and indicate extent of lease. Unless operations are commenced within 180 days after the date of approval hereof, this approval to drill will become null and void.

Name of Operator Bennett and King Phone No. Ea 2 6226
Address 330 Jersey st. City Denver State Colo.

How is liability secured: Well Bond (Attached) []; Blanket Bond []; Waiver [] (Check one)

Lease Name Mary E. Mefley
Well No. 5
Field Name Rangeley Wildcat []
County Rio Blanco

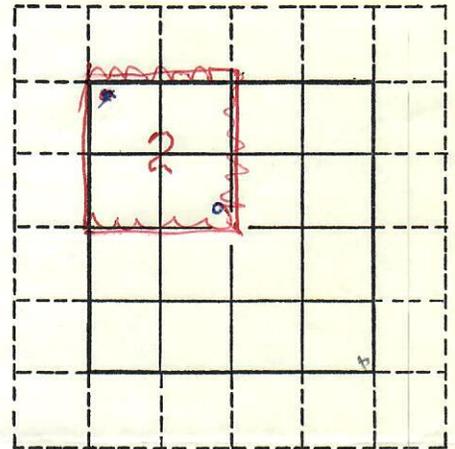

Location SE 1/4 of Section 2 Township 1 north Range 102 W Meridian 6 Pm
(quarter quarter) of South Line of East Section Line
80 feet from North Section line and 65 feet from West Section Line
N or S E or W

The well is located on: Patented land [] State land [] Federal land []

The well is located within a spaced area: Yes [] No []

Distance from proposed location to nearest property or lease line 80 feet.
Distance from proposed location to nearest drilling unit line 65 feet.

Objectives: Mancos Shale Depth 2500 more or less Shale Depth 2500 more or less
Formation Estimate Formation Estimate

Proposed length of surface casing 100 feet or feet. more

REMARKS:

Table with columns for Agent, Bond, Spot, Wells, Oil, Gas, Status. Includes handwritten 'shale' and checkmarks.

I/We hereby swear (or affirm) that the statements herein made are a full and correct report.

APPROVED:

Date June 26 1959
Director [Signature]

Company Bennett Date June 24/59
Address 330 Jersey St Phone No. Ea 2-6226
By William J. Bennett Title Owner
Signature