


R. 68W

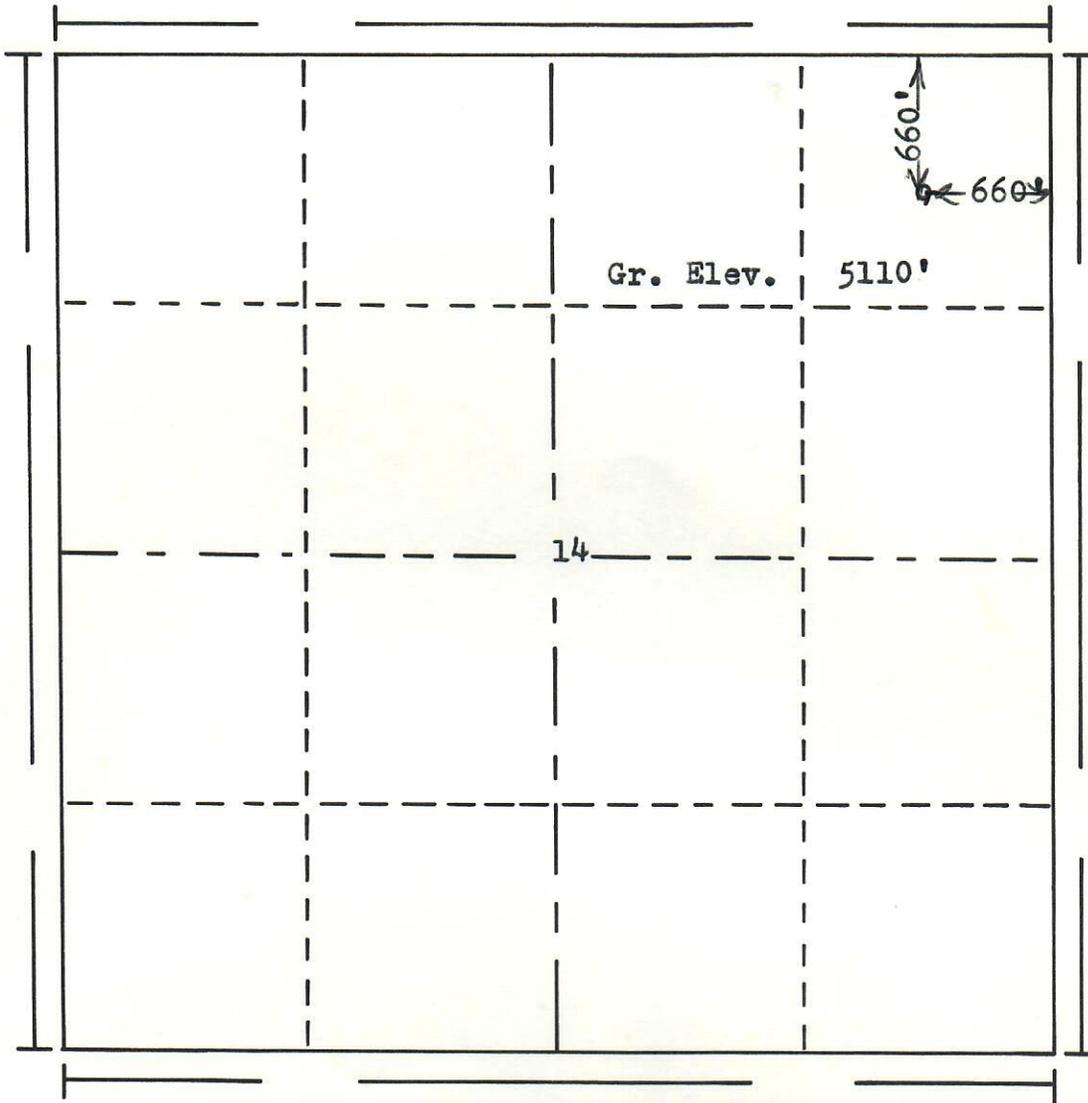

T.
1
N

Scale... 1" = 1000'

Powers Elevation Company, Inc. of Denver, Colorado has in accordance with a request from Mr. Pitchford for Champlin Petroleum Co.

determined the location of No.1 Champlin 41-14 to be CNE NE Section 14 Township 1N Range 68W of the 6th Principal Meridian Weld County, Colorado

I hereby certify that this plat is an accurate representation of a correct survey showing the location of

Date: 3-18-76

B. J. Halliday
Licensed Land Surveyor No. 2853
State of Colorado

76-219