


FINAL P&A WELL
SCHEMATIC

CHEVRON USA PRODUCTION CO.
ASSOCIATED B 3
NE SW SEC. 3, T1N, R102W

API# 05-103-06013

1974 PUMPED
150 SXS CEMENT DOWN
7" X 13 3/8 ANNULUS

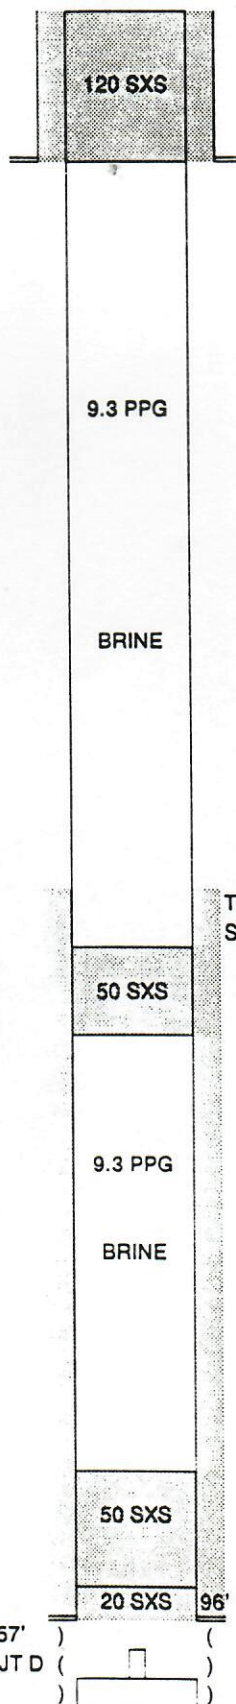

SET CMT PLUG @ 542'-SURFACE

13 3/8" 48# SURFACE CSG 0-542'
CMT'D W/300 SXS

9.3 PPG

BRINE

TOP OF CMT @ +-3125' BY TEMP
SURVEY

DAKOTA TOP @ 3420'
MORRISON TOP @ 3480'

50 SXS

SET CMT PLUG @ 3530-3290'

9.3 PPG

BRINE

50 SXS

SET CMT PLUG @ 5796-5556'

20 SXS

96'

WEBER TOP @ 5900'

6 1/8" OPEN HOLE 5923-6257')
FISH 8' WASH COLLAR, 1/2 JT D ()
PIPE @ 6257'(TOF @ 6248'))

7" 20# J-55 0-3958'
23# J-55 3960-5923'
CMT'D W/ 1000 SXS REG
& 125# FLOCALE
T.D. @ 6673'



00039123