




# OIL AND GAS CONSERVATION COMMISSION OF THE STATE OF COLORADO

## NOTICE OF INTENTION TO DRILL

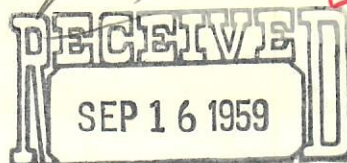

OIL & GAS  
CONSERVATION COMMISSION

### INSTRUCTIONS:


A notice of intention to drill a well shall be filed in duplicate on all Federal and Patented lands, and in triplicate on all State lands. Do not begin operations until approved copy has been received. It is mandatory that the proposed location comply with all rules and regulations of the Commission. Locate well on section grid in proper location, and indicate extent of lease. Unless operations are commenced within 180 days after the date of approval hereof, this approval to drill will become null and void.

Name of Operator Caldwell & Covington Phone No. 1060  
Address P.O. Box 473 City Vernal State Utah

How is liability secured: ☐ Well Bond (Attached) ☐ Blanket Bond ☐ Waiver ☐  
(Check one)

(On file with U.S.G.S.)

No. XXXX C-0634  
Well No. Yellowstone 2-A  
Field Name Rangely Shale Wildcat ☐  
County Rio Blanco

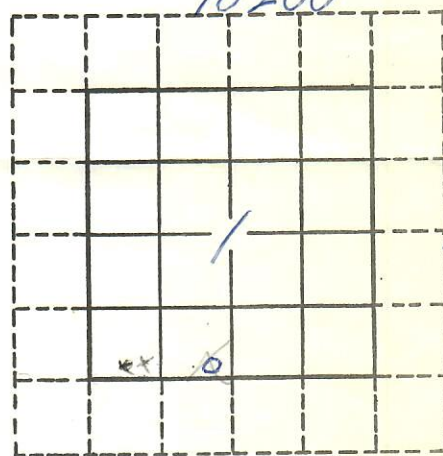

Location SE SE SW (quarter quarter) Section 1 Township 1N Range 102W Meridian 6th  
100 feet from S Section line and 570 feet from W Section Line  
N or S E or W

The well is located on: Patented land ☐ State land ☐ Federal land ☒

The well is located within a spaced area: Yes ☐ No ☒

Distance from proposed location to nearest property or lease line none feet.

Distance from proposed location to nearest drilling unit line none feet.

Objectives: Mancos Depth 4400' ; Formation Depth Estimate

Proposed length of surface casing 120 feet.

|          |             |
|----------|-------------|
| Agent    | <u>6K</u>   |
| Bond     | <u>1000</u> |
| Spot     |             |
| 600 ft.  |             |
| 1200 ft. |             |
| Wells    |             |
| Oil      |             |
| Gas      |             |
| Status   |             |

### REMARKS:

Operator proposes to set approximately 120 feet of 8-5/8" surface casing and cement casing from top to bottom, then to drill 6-1/4" hole using rotary tools and air as drilling medium to proposed depth of 4400 feet unless gas or oil is encountered in commercial quantities. Well will spud in Mancos formation and be in Mancos to total depth.

I/We hereby swear (or affirm) that the statements herein made are a full and correct report.

### APPROVED:

Date Sept 8 1959

Company Caldwell & Covington Date Sept. 3, 1959

Address P.O. Box 473, Vernal, Utah Phone No. 1060

By Robert E. Covington Title Partner

Director

Signature

entered in Int Ak - 9-17/59.