




VERBAL REQUEST

NOTICE OF INTENTION TO DRILL _____

Bonding Status _____

NOTICE OF INTENTION TO ABANDON _____

OTHER Corrected Location

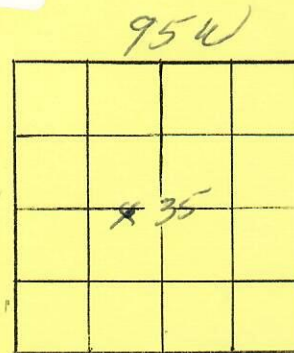

COMPANY Continental Energy ADDRESS _____

BY _____ Title _____ PHONE NO. _____
Extension _____

WELL NO. _____ LEASE _____

COUNTY _____ FIELD _____

Location NE NW Sec. 35 Twp. 1N Rge. 95W Meridian _____
15' feet from N Section line, and 1846' feet from W Section Line
N or S E or W

ESTIMATED DATE OF WORK _____ ESTIMATED TIME _____

DETAILS OF PLAN OF WORK: T.D. _____ FORMATION _____

SURFACE CASING _____

Corrected Loc.
7m 4 to come in

APPROVED BY H. H. Monell

DATE 12/8/69

