


## CERTIFICATE OF SURVEY

for

B. F. Allison


00080067

T2N R57W 6 PM.

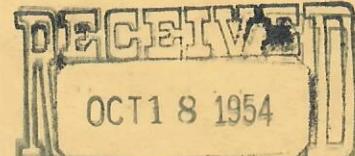

OIL &amp; GAS

CONSERVATION COMMISSION

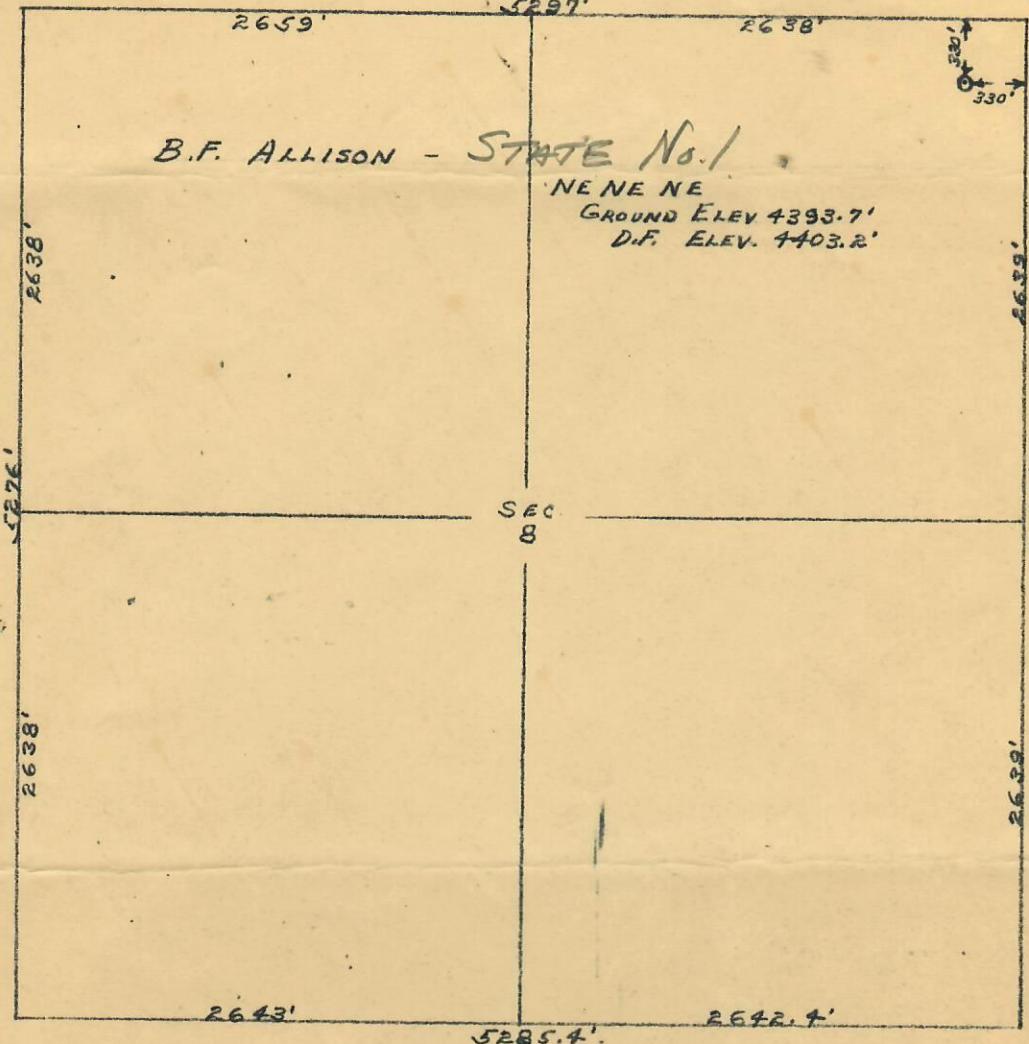

I hereby certify that the above plat is an accurate representation of a correct survey showing the location of B.F.Allison- STATE Oilwell located in the NE $\frac{1}{4}$ NE $\frac{1}{4}$ NE $\frac{1}{4}$  Sec.8 T2N R57W 6 PM. The elevation of the ground at the stake is 4393.7 feet above sea level from U.S.C.&G.Bench Mark. D.F. Elevation is 4403.2 feet

Fort Morgan, Colorado  
October 10, 1954

*Levitt*  
Registered Professional Engineer  
State of Colorado

