

RECEIVED


JAN 16 1981

COLO. OIL & GAS CONS. COMM. N



FORM F-106

R. 55W

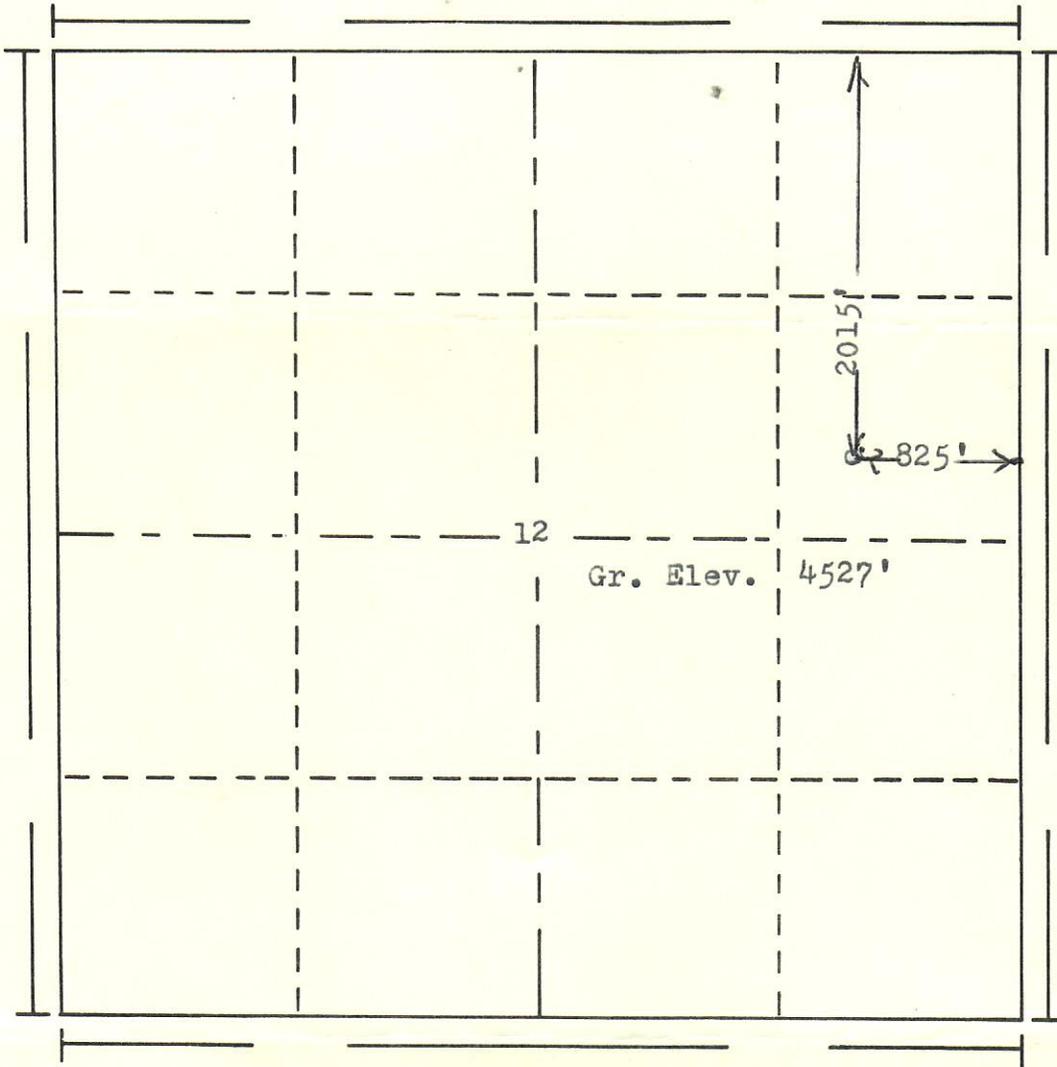

T.
2
N

Scale... 1" = 1000'

Powers Elevation of Denver, Colorado
has in accordance with a request from Mr. Westmoreland
for Snowden Oil Co.

determined the location of No. 4 Davie
to be 2015' FN & 825' FE Section 12 Township 2N
Range 55W of the 6th Principal Meridian
Morgan County, Colorado

I hereby certify that this plat is an
accurate representation of a correct
survey showing the location of



Date: 1-7-81

Brian J. Halloran
Licensed Land Surveyor No. 2853
State of Colorado