




RECEIVED

SEP 14 1970

COLO. OIL & GAS CONS. COMM.

R 55W

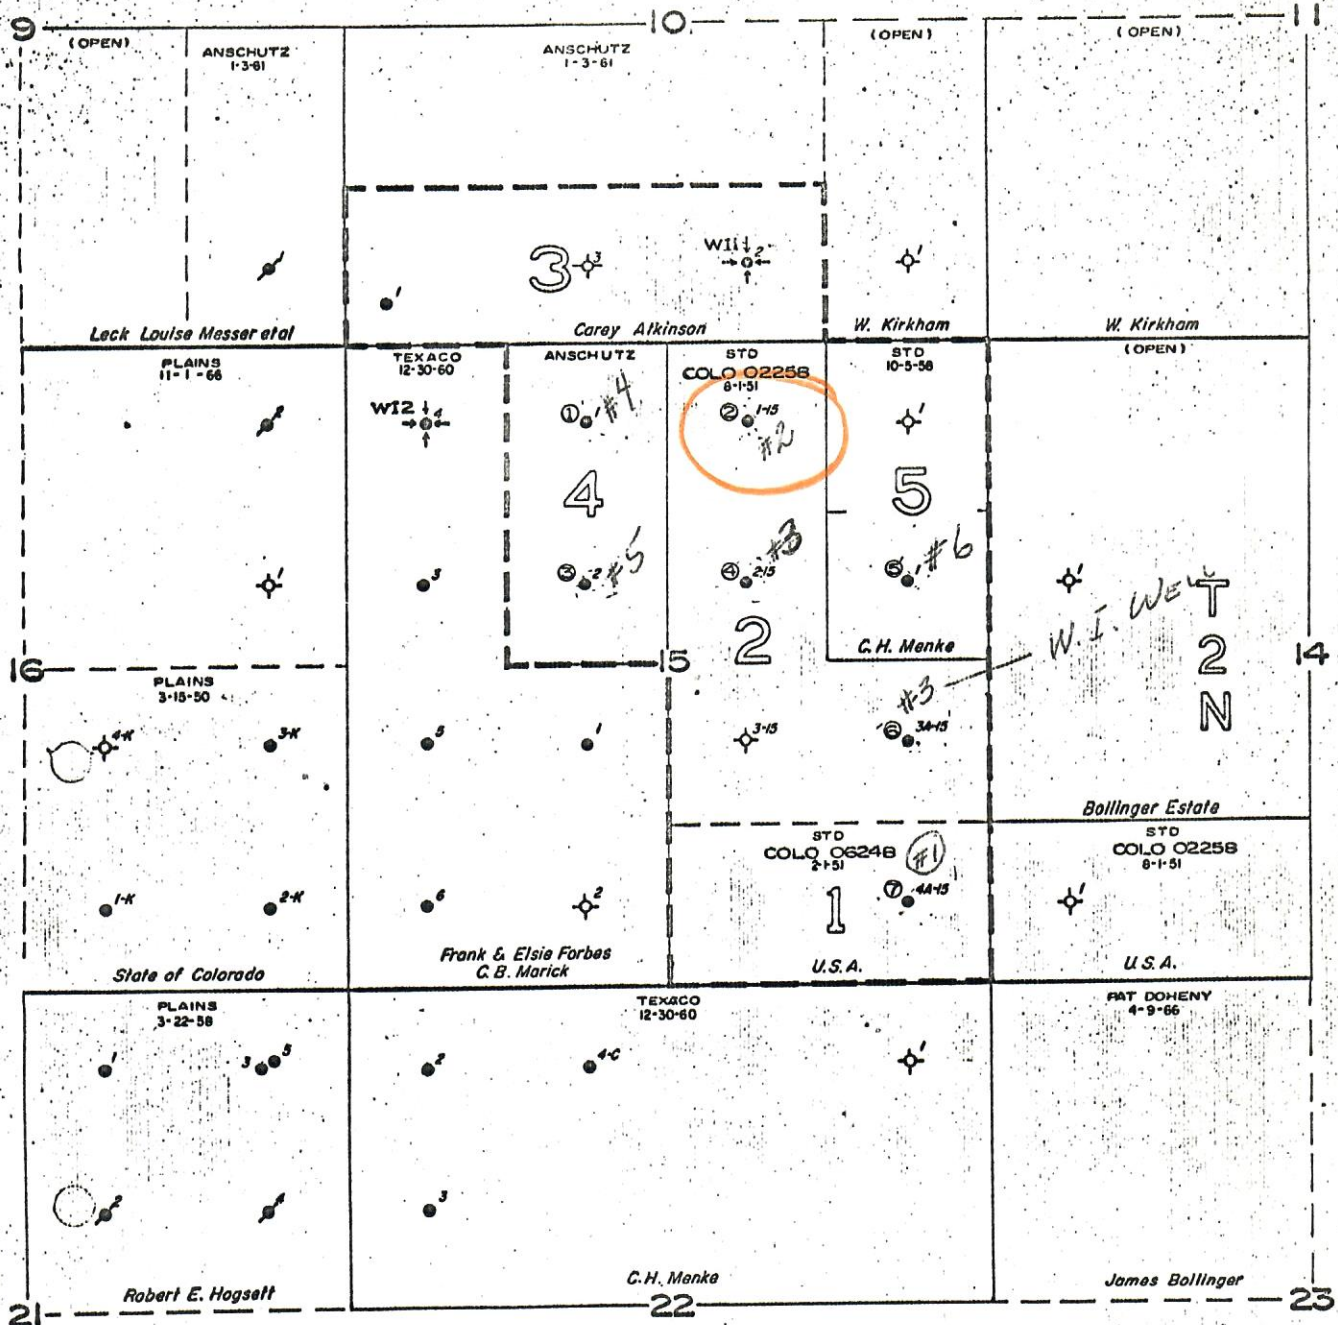

ZORICHAK "D" SAND UNIT MORGAN COUNTY, COLORADO

LEGEND

- ✱ DRY HOLE
- ⊕ INJECTION WELL
- UNIT BOUNDARY
- 10 TRACT NUMBER



EXHIBIT "A"