Dolly Varden 41-20
WELL SCHEMATIC

Surface Loc: NWSE Sec 20 T19S R69W
BH Loc: NWSE Sec 20 T19S R69W
County: Fremont **State:** Colorado
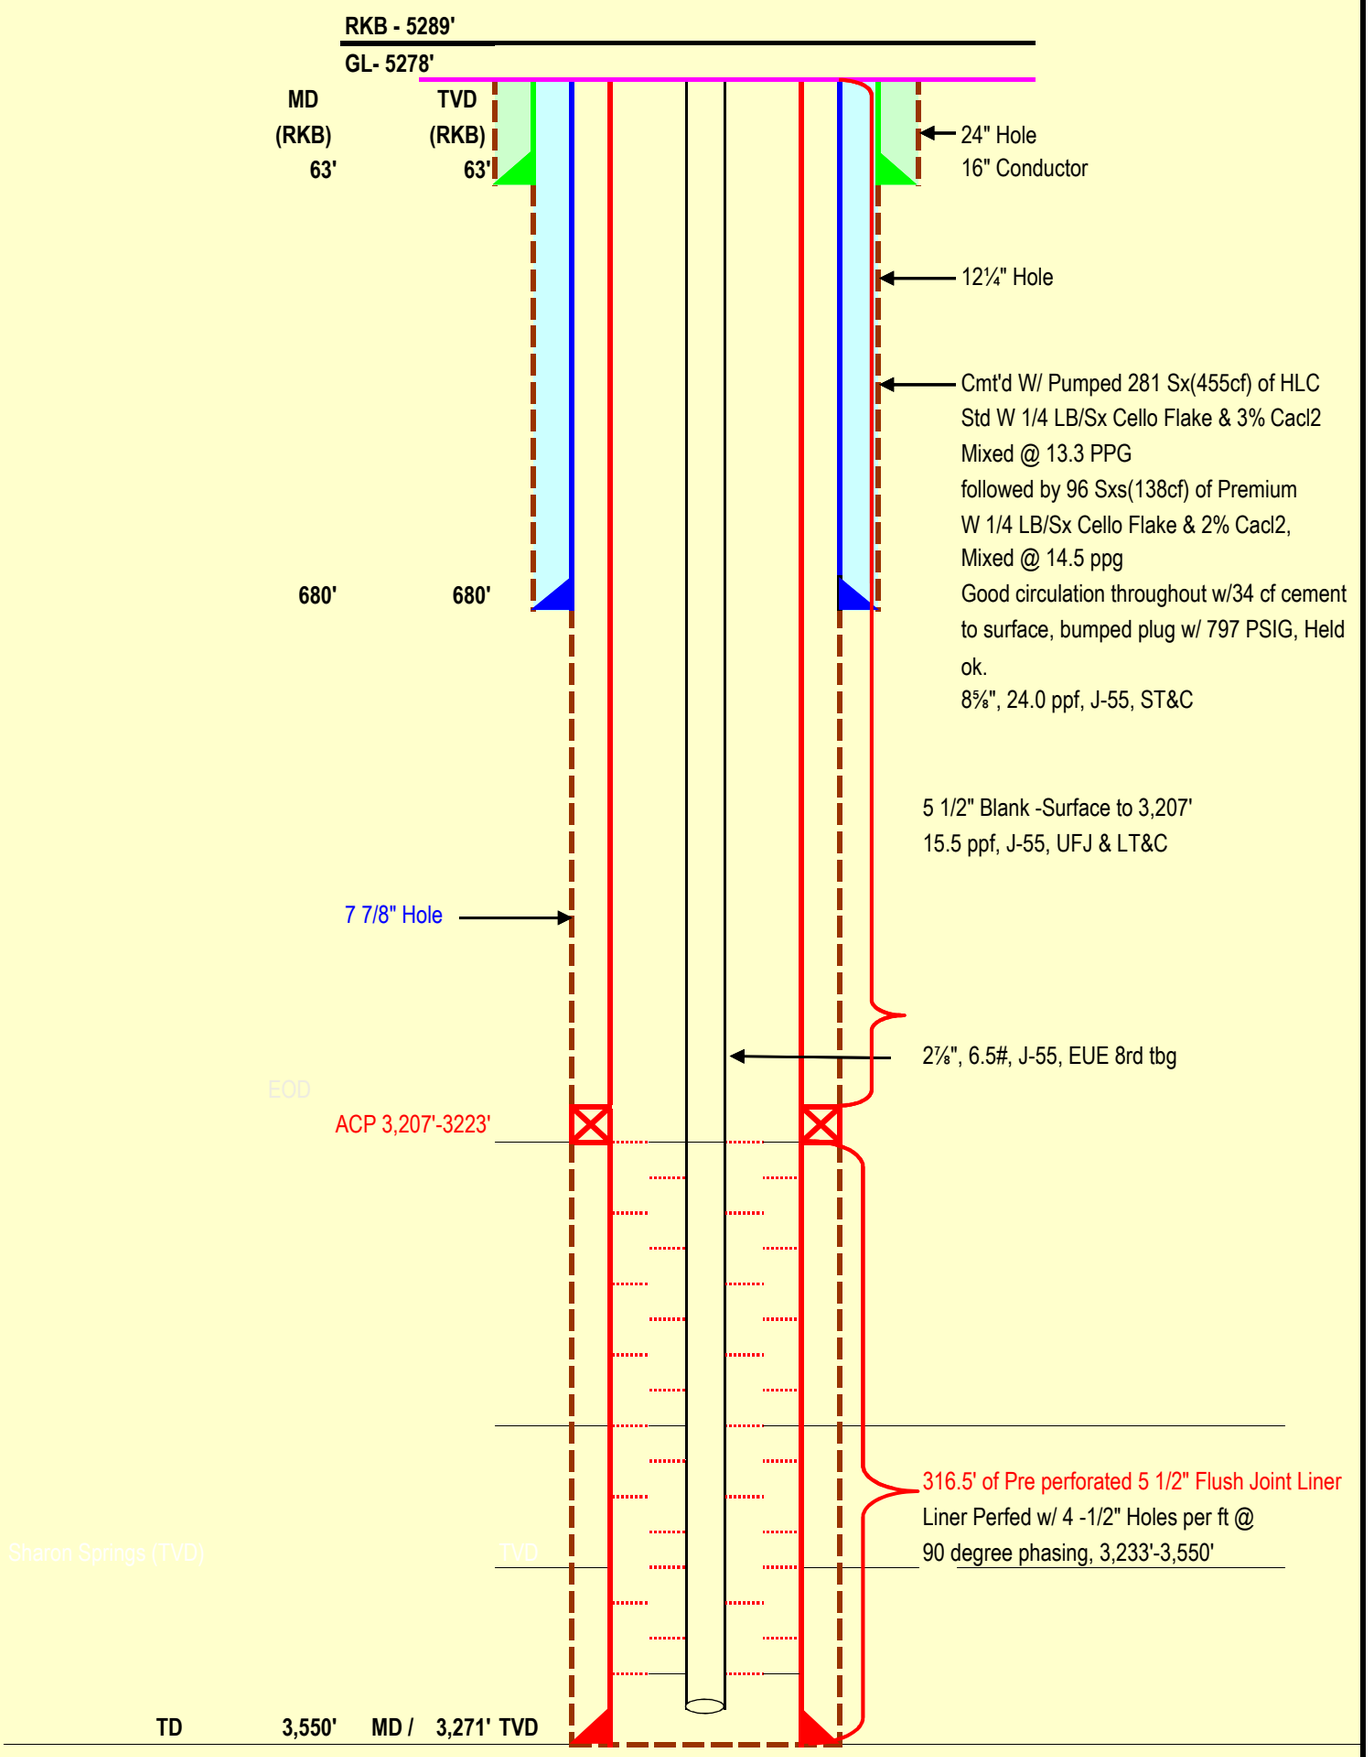
TD: 3,550' MD
TVD: 3,271' TVD