SWORDFISH 13-31
Wellbore Schematic

Surface Loc: NWSW Sec 31-T19S-R69W
BH Loc: SWSE Sec 31-T19S-R69W
County: FREMONT State: CO

TD: 4,787' MD
TVD: 3,682' TVD

API No.: 05-043-06212

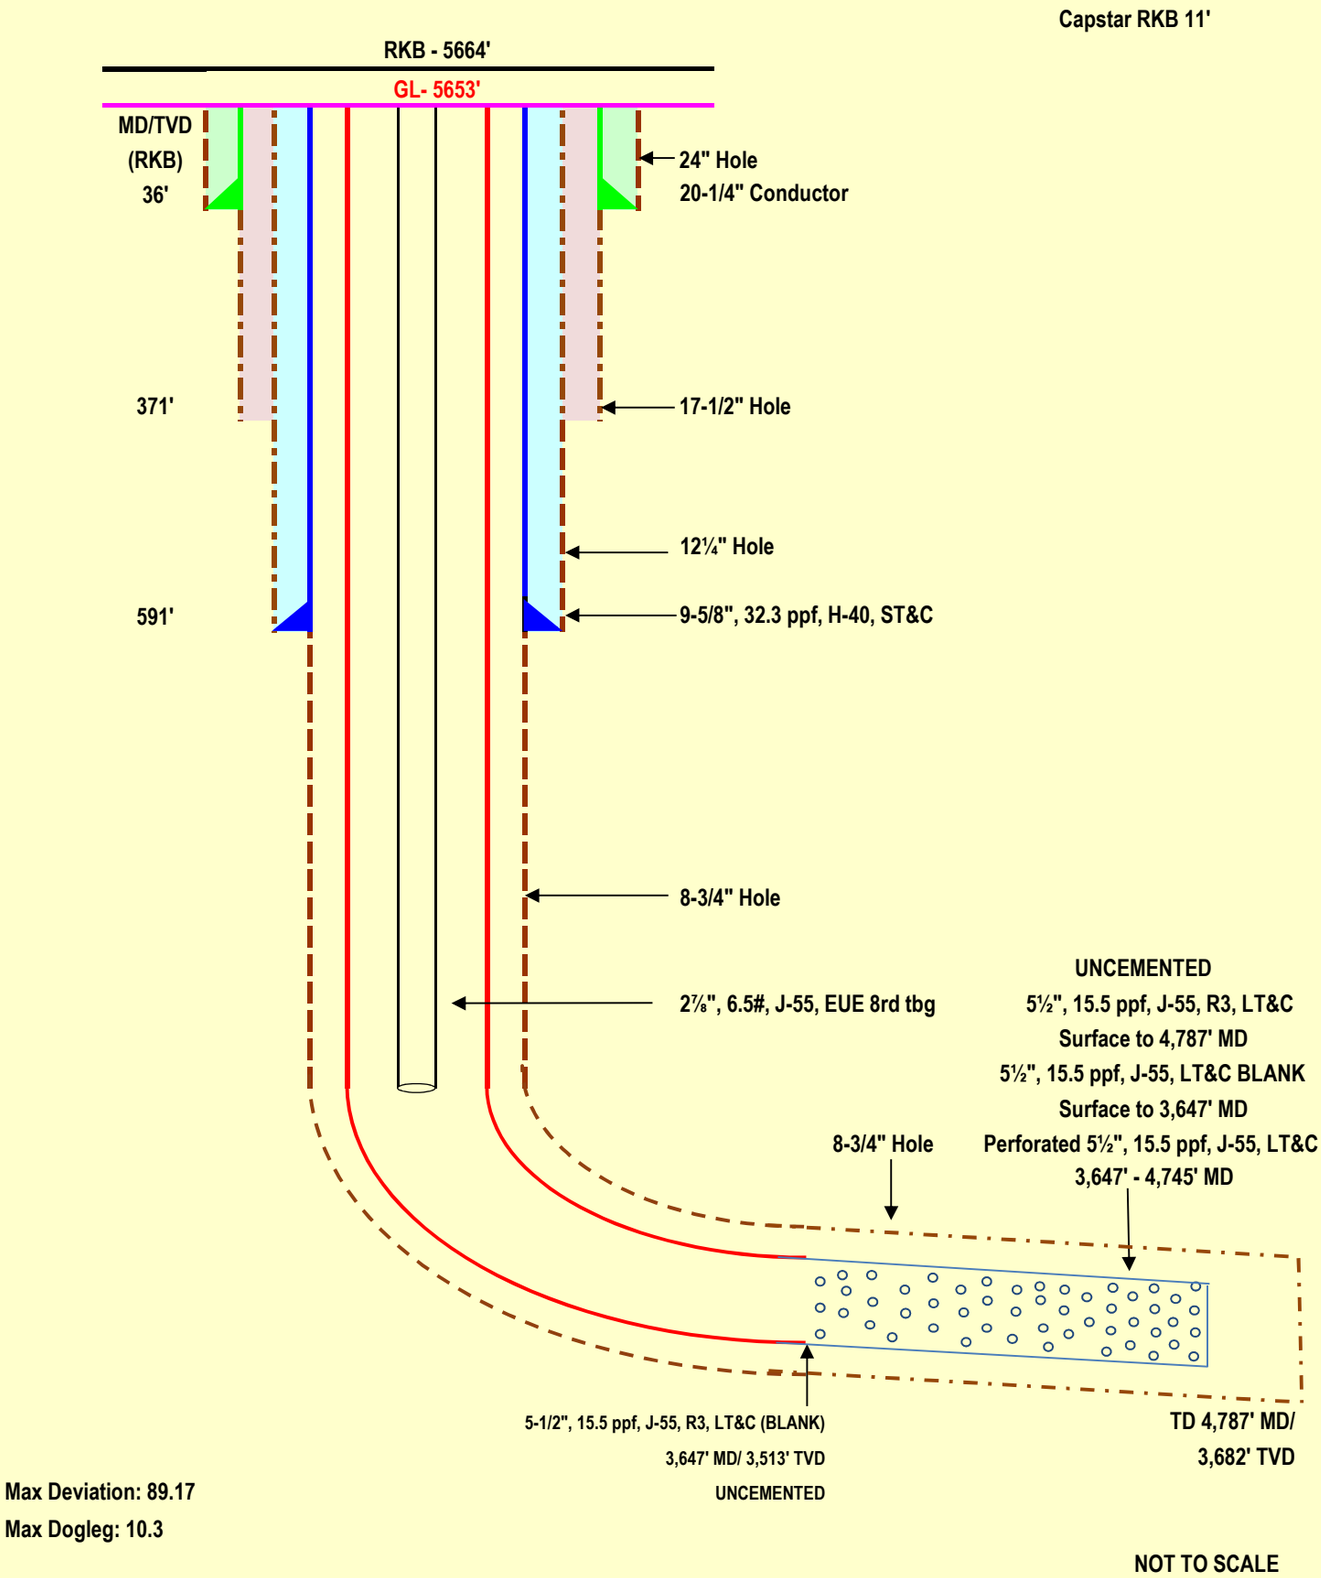

Max Deviation: 89.17
Max Dogleg: 10.3

NOT TO SCALE