Section 17

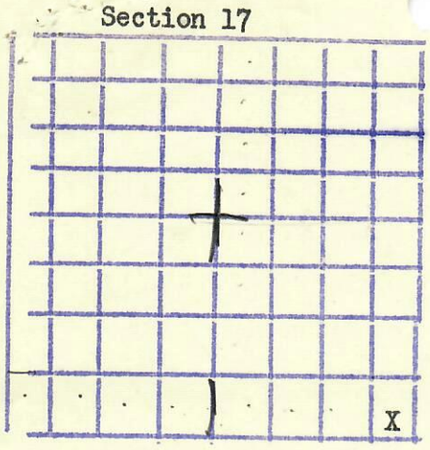

Locate Well Correctly

OFFICE OF STATE OIL INSPECTOR
Oil and Gas Conservation Department

- -

LOG OF OIL AND GAS WELL

BEST IMAGE AVAILABLE

Company Shell Oil Company — Address 413 Denham Building, Denver 2, Colo.
State or Patented Kirk Field Walker — State Colorado
Well No. 1 Sec. 17 T. 9N R. 53W — Meridan ____ County Logan
Location 330 Ft. (N) of S Line and 330 Ft. (W) of E line of SE/4 Elevation 4138
(Derrick floor relative to sea level)

The information given herewith is a complete and correct record of the well and all work done thereon so far as can be determined from all available records.

Date October 3, 1951 — Signed ____
Title Division Production Manager

The summary on this page is for the condition of the well as above date.
Commenced drilling July 10, 1951 Finished Frilling August 11 1951

OIL SANDS OR ZONES

No. 1, from 4766 to 4870
No. 2, from ____ to ____
No. 3, from ____ to ____
No. 4, from ____ to ____
No. 5, from ____ to ____
No. 6, from ____ to ____

IMPORTANT WATER SANDS

No. 1, from None to ____
No. 2, from ____ to ____
No. 3, from ____ to ____
No. 4, from ____ to ____

CASING RECORD

Size	Weight per ft.	Amount	Cut & Pulled from	Perforated From	To	Purpose
8 5/8"	32	402	---	---	---	---
4 1/2"	9½	5030	---	4927	4932	Oil Zone

MUDDING AND CEMENTING RECORD

Size	Where Set	No. Sacks of Cement	Methods used	Mud Gravity	Amount of Mud Used
8 5/8"	402	200			
4 1/2"	5030	250			

HYDRAFRACING OR SHOOTING RECORD

Size	Shell Used	Explosive Used	Quantity	Date	Depth Shot	Depth Cleaned Out
			None			

TOOLS USED

Rotary Tools used from 0 ft. to 5033 ft. and from --- ft. to --- ft.
Cable tools were used from 5033 ft. to 4967 ft. and from --- ft. to --- ft.

DATES

____ 19____ Put to producing August 11 1951

The production for the first 24 hours was 183 barrels of fluid of which 100 % was oil, 0 % water; Gravity °API 37.9° at 60
If gas well, cu. ft. per 24 hours ---.
Rock Pressure, lbs. per sq. in ---

FORMATION RECORD

From	Tops	Total Feet	Formation
	3965		Niobrara
	4266		Timpas
	4327		Codell
	4510		Greenhorn
	4766		Muddy
	4870		Dakota