



# OIL AND GAS CONSERVATION COMMISSION OF THE STATE OF COLORADO

MAY 2 1958

## NOTICE OF INTENTION TO DRILL

OIL & GAS  
CONSERVATION COMMISSION


### INSTRUCTIONS:

A notice of intention to drill a well shall be filed in duplicate on all Federal and Patented lands, and in triplicate on all State lands. Do not begin operations until approved copy has been received. It is mandatory that the proposed location comply with all rules and regulations of the Commission. Locate well on section grid in proper location, and indicate extent of lease. Unless operations are commenced within 180 days after the date of approval hereof, this approval to drill will become null and void.

Name of Operator A. T. SKAER ET AL Phone No. EAST 2-8641  
Address 3250 MONACO PARKWAY City DENVER State COLORADO

How is liability secured: Well Bond (Attached) ☐; Blanket Bond ☐; Waiver ☐  
(Check one)

Lease Name J. F. KIRK  
Well No. 2  
Field Name NORTH MOUNT HOPE - North Wildcat ☐  
County LOGAN COUNTY, COLORADO

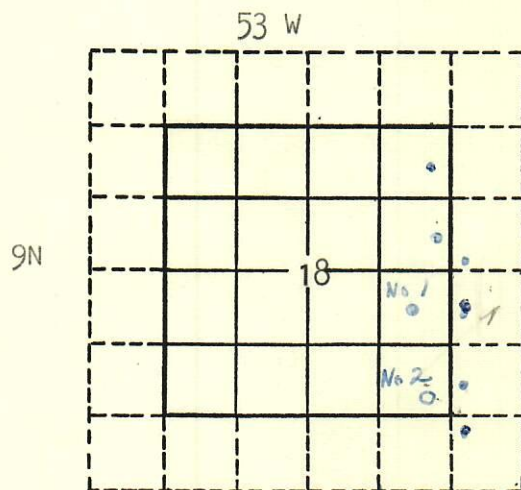

Location SE 1/4 (quarter quarter) Section 18 Township 9N Range 53W Meridian 6E  
330 feet from SOUTH Section line and 330 feet from EAST Section Line  
N or S E or W

The well is located on: Patented land ☒ State land ☐ Federal land ☐

The well is located within a spaced area: Yes ☒ No ☐ Cause 41

Distance from proposed location to nearest property or lease line 330 feet.

Distance from proposed location to nearest drilling unit line 330 feet.

Objectives: "D" SAND Formation Depth 4830 Estimate; "J" SAND Formation Depth 5000 Estimate

Proposed length of surface casing 200' - 8-5/8" feet.

REMARKS:

*Handwritten notes:*  
Name sent to Skaer by 10/10/58  
Spudled Oct. 13, 1958  
nebraska oil  
Am 6-1769

Area	AP
Bond	Waived
Expl. OK or per	
800 ft. order #	
MOD #	41-4
Well	892
Oil	
Gas	
Status	

I/We hereby swear (or affirm) that the statements herein made are a full and correct report.

APPROVED:

Date JUN 17 1958

A. J. [Signature]  
Director

Company A. T. SKAER ET AL Date 4/25/58

Address 3250 MONACO ST. PARKWAY Phone No. EAST 2-8641

By [Signature] Title Part owner & operator  
Signature