





CERTIFICATE OF SURVEY
for
Signet Oil Co.
Logan County, Colorado
T9N R53W 6PM.

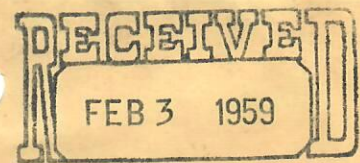

OIL & GAS
CONSERVATION COMMISSION

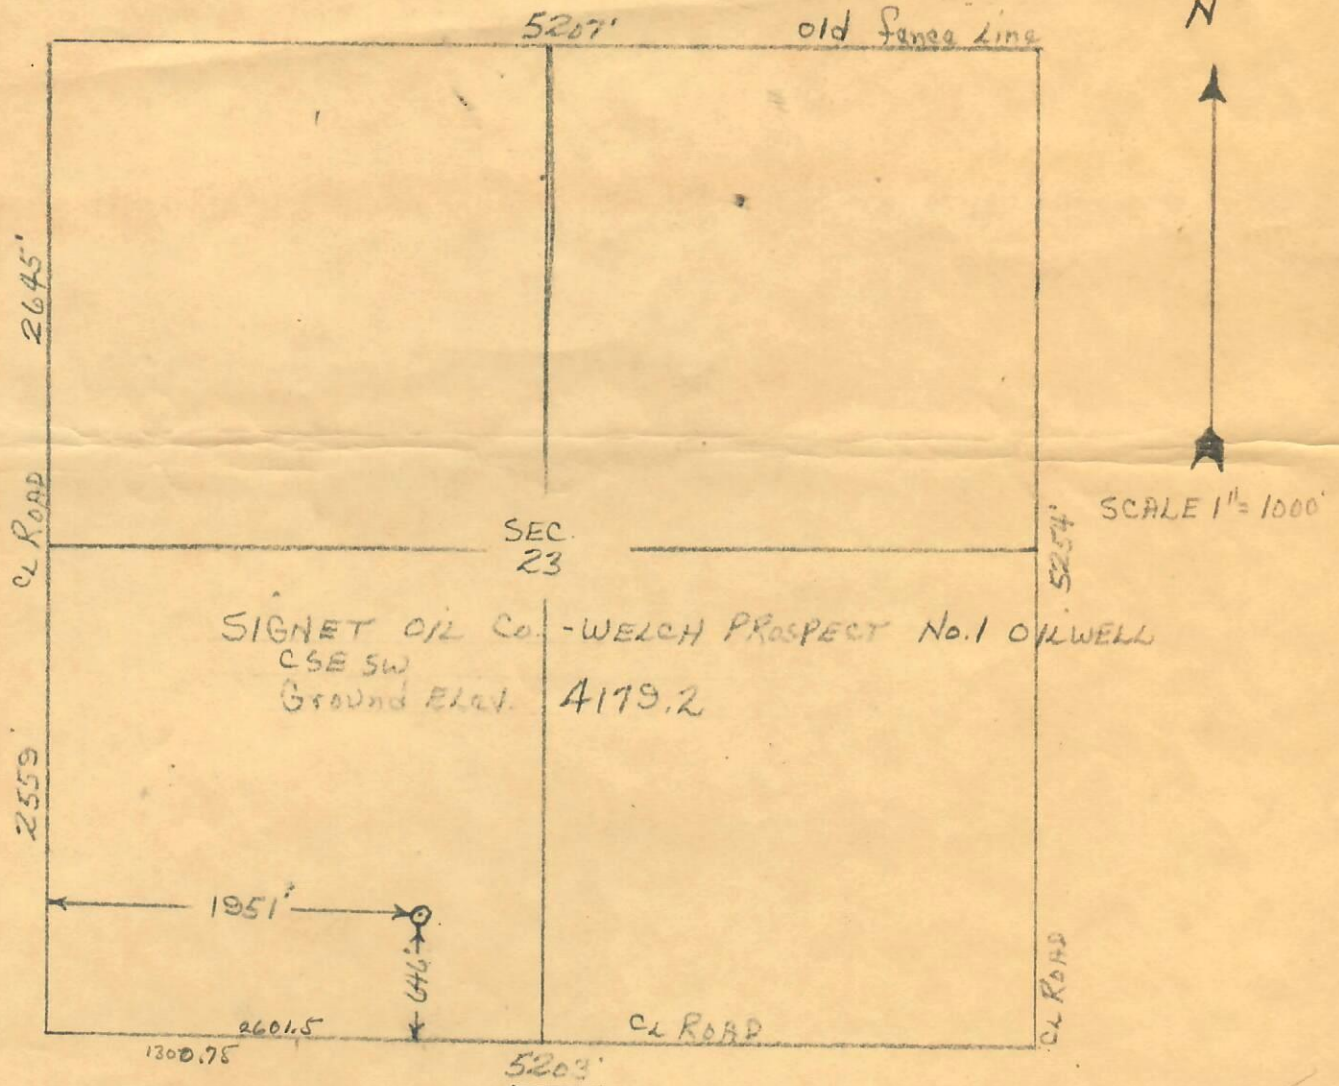

I hereby certify that the above plat is an accurate representation of a correct survey showing the location of Signet Oil Co.-Welch prospect No. 1 Oilwell in C SE 1/4 SW 1/4 Sec. 23 T9N R53W 6PM. The elevation of the ground at the stake is 4179.2 feet above sea level from U.S.G.S bench Mark.

Fort Morgan, Colorado
Jan. 23, 1959

Charles J. Coburn
Registered Professional Engineer
State of Colorado.