




OIL AND GAS CONSERVATION COMMISSION OF THE STATE OF COLORADO

NOTICE OF INTENTION TO DRILL

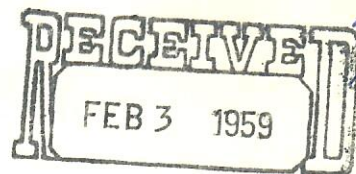

OIL & GAS
CONSERVATION COMMISSION

INSTRUCTIONS:

A notice of intention to drill a well shall be filed in duplicate on all Federal and Patented lands, and in triplicate on all State lands. Do not begin operations until approved copy has been received. It is mandatory that the proposed location comply with all rules and regulations of the Commission. Locate well on section grid in proper location, and indicate extent of lease. Unless operations are commenced within 180 days after the date of approval hereof, this approval to drill will become null and void.

Name of Operator SIGNET OPERATING AND EXPLORATION CO. Phone No. Amherst 6-3129
Address 245 Petroleum Club Building City Denver State Colorado


How is liability secured: Well Bond (Attached) ☒; Blanket Bond ☐; Waiver ☐
(Check one)

Lease Name Welsh

Well No. 1

Field Name Wilcat ☒

County Logan

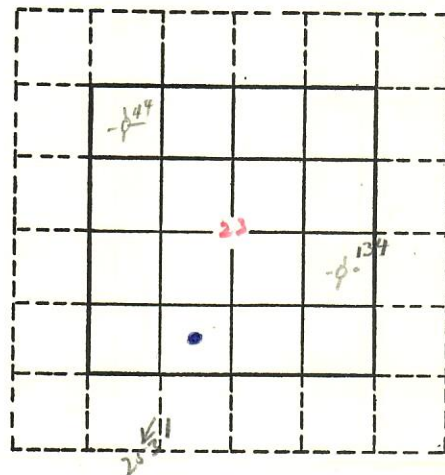

Location C SE SW Section 23 Township 9N Range 53W Meridian 6th
(quarter quarter)
646 feet from N-S Section line and 1951 feet from W Section Line
N or S E or W

The well is located on: Patented land ☒ State land ☐ Federal land ☐

The well is located within a spaced area: Yes ☐ No ☒

Distance from proposed location to nearest property or lease line 646 feet.

Distance from proposed location to nearest drilling unit line 646 feet.

Objectives: "D" Depth 4800'; "J" Depth 5000'
Formation Estimate Formation Estimate

Proposed length of surface casing 100 feet.

REMARKS:

*Called re: surface casing.
Will set through Blue shale.
DOR*

Agent	<u>OK</u>
Bond	<u>Indy Bond att.</u>
Spot	
600 ft.	<u>OK</u>
1200 ft.	<u>OK</u>
Wells	
Oil	
Gas	
Status	

I/We hereby swear (or affirm) that the statements herein made are a full and correct report.

APPROVED:

Date FEB - 3 1959

A. J. Gervin
Director

SIGNET OPERATING AND EX-
Company PLORATION COMPANY Date 1-27-59

Address 245 Petroleum Club Bldg. Phone No. AM 6-3129

By KE Dutton Title Secy-Treas.
Signature