Section 17

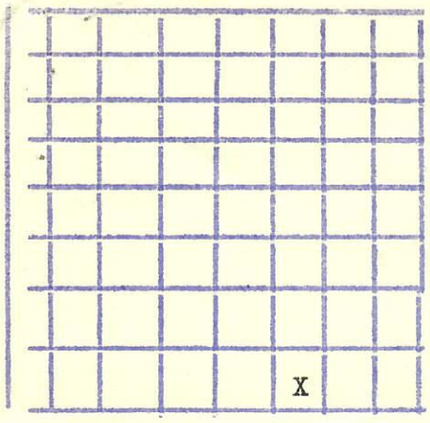


Locate Well Correctly

00823950

BEST IMAGE AVAILABLE

OFFICE OF STATE OIL INSPECTOR
Oil and Gas Conservation Department

LOG OF OIL AND GAS WELL

Company Shell Oil Company Address 413 Denham Bldg., Denver 2, Colo.
State or Patented Kirk A Field Walker State Colorado
Well No. 2 Sec. 17 T. 9N R. 53W Meridan County Logan
Location 330 Ft. (N) of S Line and 1650 Ft. (W) of E line of SE/4 Elevation 4140
(Derrick floor relative to sea level)

The information given herewith is a complete and correct record of the well and all work done thereon so far as can be determined from all available records.

Signed
Date October 10, 1951 Title Division Production Manager

The summary on this page is for the condition of the well as above date.
Commenced drilling August 22, 1951 Finished Frilling September 13, 1951

OIL SANDS OR ZONES

No. 1, from 4797 to 4901
No. 2, from to
No. 3, from to
No. 4, from to
No. 5, from to
No. 6, from to

IMPORTANT WATER SANDS

No. 1, from None to
No. 2, from to
No. 3, from to
No. 4, from to

CASING RECORD

| Size | Weight per ft. | Amount | Cut & Pulled from | Perforated From | Perforated To | Purpose |
|---|---|---|---|---|---|---|
| 8 5/8" | 24 | 227 | --- | --- | --- | --- |
| 4 1/2" | 9½ | 5028 | | 4950 | 4956 | Oil Zone |

MUDDING AND CEMENTING RECORD

| Size | Where Set | No. Sacks of Cement | Methods used | Mud Gravity | Amount of Mud Used |
|---|---|---|---|---|---|
| 8 5/8 | 227 | 170 | | | |
| 4 1/2 | 5028 | 250 | | | |

HYDRAFRACING OR SHOOTING RECORD

| Size | Shell Used | Explosive Used | Quantity | Date | Depth Shot | Depth Cleaned Out |
|---|---|---|---|---|---|---|
| | | None | | | | |

TOOLS USED

Rotary Tools used from 0 ft. to 5063 ft. and from --- ft. to --- ft.
Cable tools were used from 5063 ft. to 4968 ft. and from --- ft. to --- ft.

DATES

19 Put to producing September 13, 1951

The production for the first 24 hours was 195 barrels of fluid of which 100 % was oil, 0 % water; Gravity °API
If gas well, cu. ft. per 24 hours ---.
Rock Pressure, lbs. per sq. in ---

FORMATION RECORD

| From | Tops | Total Feet | Formation |
|---|---|---|---|
| | 3978 | | Niobrara |
| | 4293 | | Timpas |
| | 4349 | | Codell |
| | 4539 | | Greenhorn |
| | 4797 | | Muddy |
| | 4901 | | Dakota |