




Holloway & Holloway, Inc.
P.O. Box 3331
Greeley, CO 80633
(303) 867-3715
(303) 352-5852

R52W



DEC 28 1995
JAN - 2 1996

NW cor. CL
Road South &
West

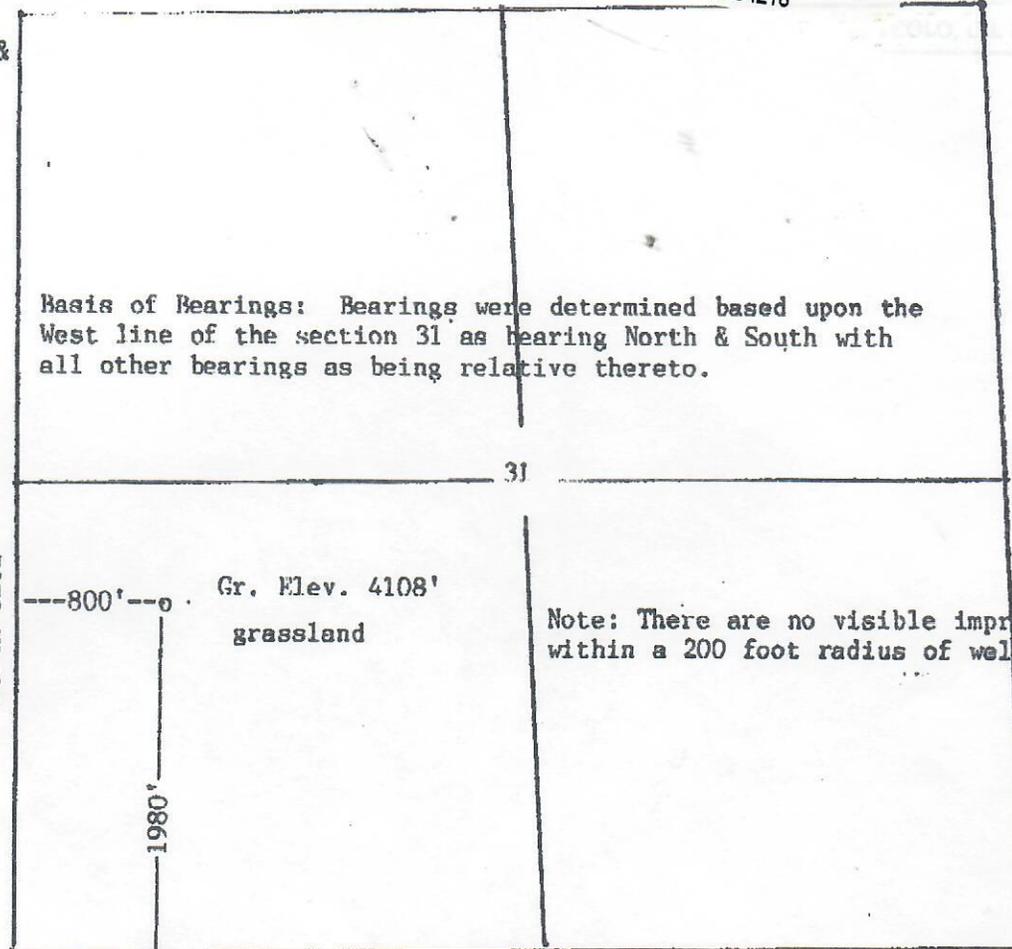

Basis of Bearings: Bearings were determined based upon the West line of the section 31 as bearing North & South with all other bearings as being relative thereto.

Note: There are no visible improvements within a 200 foot radius of wellsite

SW cor. CL T-road North
Basis of elev spot elev
at SW cor. 4097'

N89°10'E 5650'

SE cor. re-bar
in roadway

Scale --- 1" = 1000'

In accordance with a request from Edward Mike Davis
the Undersigned has determined the location of the No.13-31 Bollish well
to be 1980'FSL & 800'FWL at right angles as co-ordinates
Section 31 Township 9N Range 52W of the 6th principal Meridian
Logan County, Colorado.

I hereby certify,
that this oil and/or gas well location certificate was prepared for Edward Mike Davis
that it is not a land survey plat or improvement survey plat, and that it is not to be relied upon for the
establishment of fence, building or other future improvement lines.

Date 12-28-95

Richard J. Holloway
Holloway & Holloway, Inc.
States of
Colorado, Nebraska, Wyoming

