




RECEIVED

DEC 30 1970

COLO. OIL & GAS CONS. COMM.

R. 56W

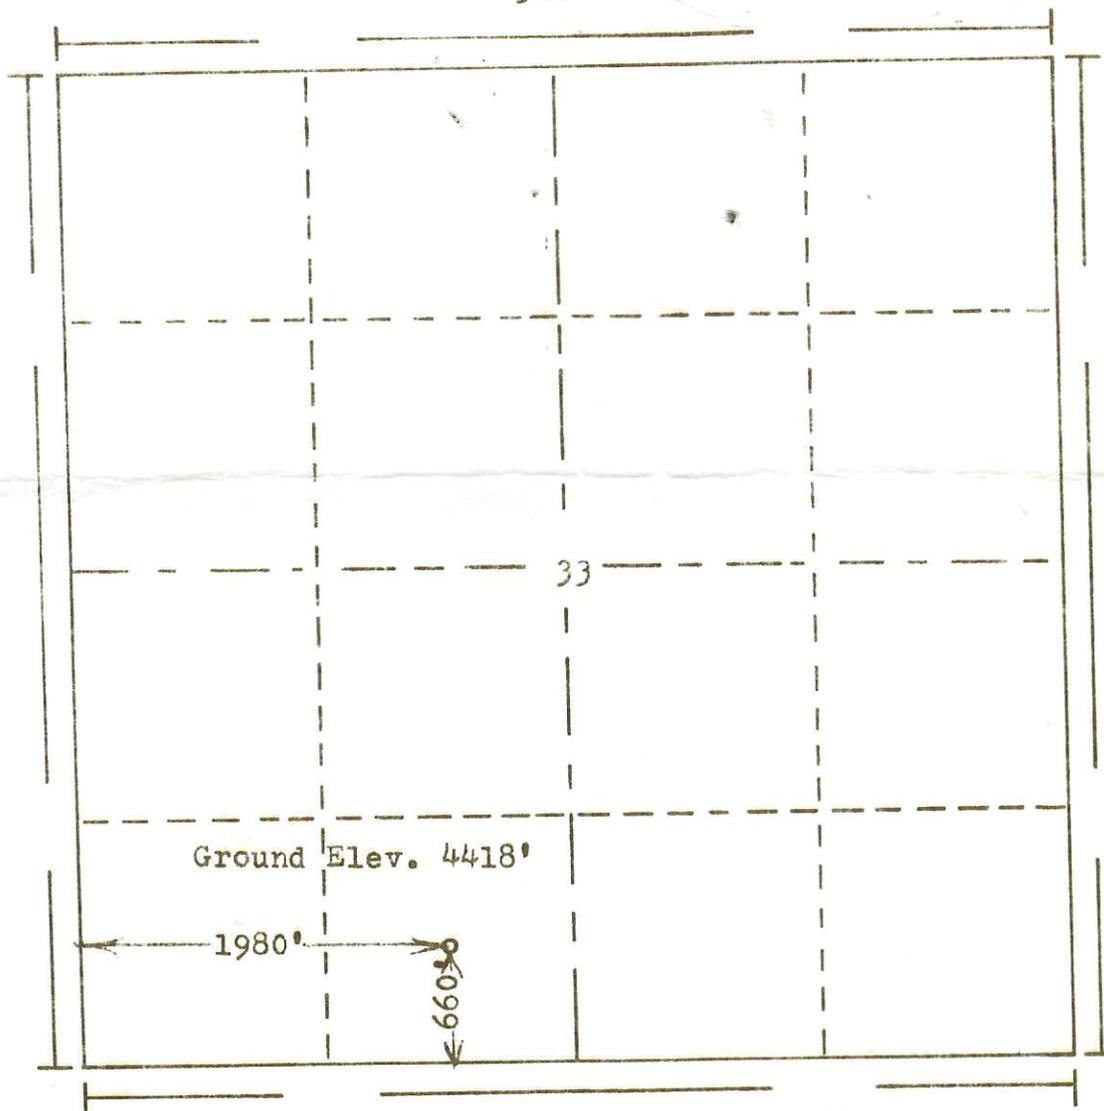

Scale... 1" = 1000'

Powers Elevation Company, Inc. of Denver, Colorado has in accordance with a request from Mr. Durr for Tiger Oil Co.

determined the location of No. 1 Peterson et al to be CSE SW Section 33 Township 2N Range 56W of the 6th Principal Meridian Morgan County, Colorado

70-757

I hereby certify that this plat is an accurate representation of a correct survey showing the location of

Date 12-1-70

[Signature]  
Licensed Land Surveyor No. 2853  
State of Colorado