


RECEIVED
JUL 20 1966

R. 56W

OIL & GAS
CONSERVATION COMMISSION

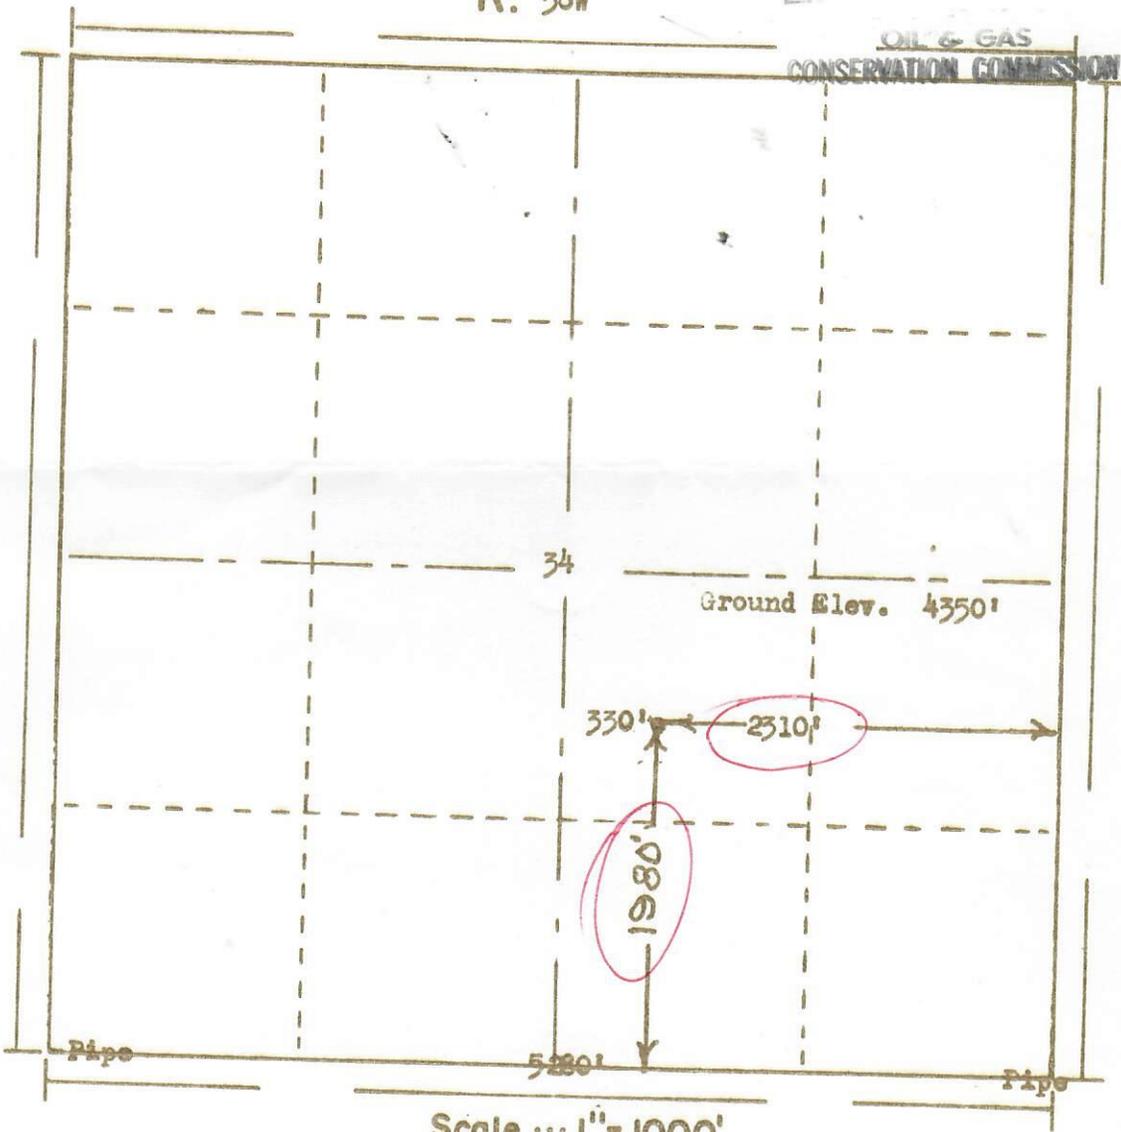

T.
2
N

Scale ... 1" = 1000'

Powers Surveyors, Inc. of Denver, Colorado
 has in accordance with a request from Mr. Harrison
 for Cardinal Petroleum determined the
 Location of No. 2 Peterson
 to be 330' West of CNW SE Section 34 Township 2N
 Range 56W of the 6th Principal Meridian
 Morgan County, Colorado

I hereby certify that this plat is an
 accurate representation of a correct
 survey showing the location of

66-261



00105026

Date: 7-16-66

B. G. Hollaway
 Licensed Land Surveyor No. 2853
 State of Colorado