


RECEIVED  
SEP - 6 1960

OIL & GAS  
CONSERVATION COMMISSION

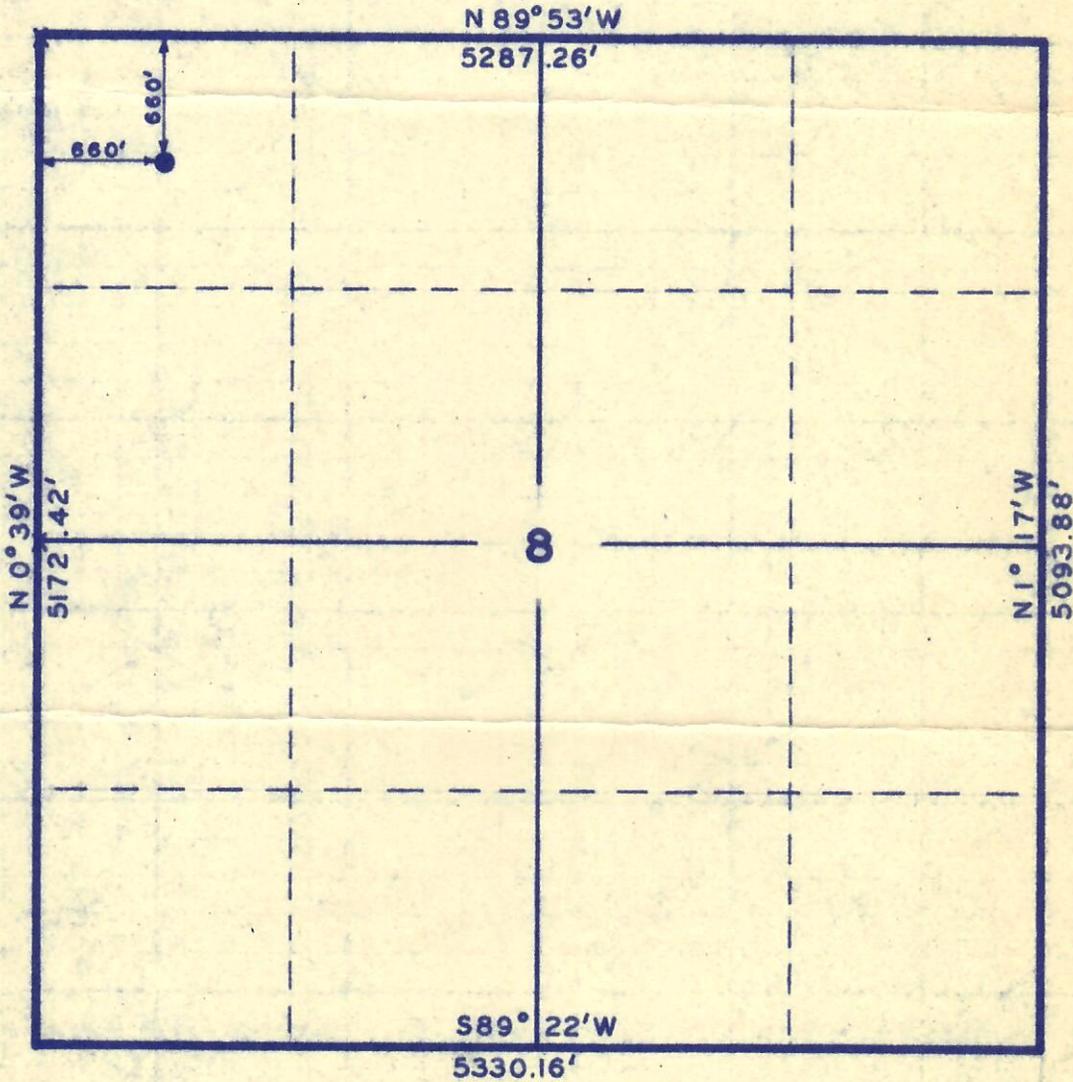

# T 9N, R90 W, 6TH PM



X = Corners located

Scale: 1" = 1000'

By: ROSS CONSTRUCTION CO.  
Vernal, Utah



PARTY  
Gene Stewart  
Lanny Taylor  
WEATHER Clear-Warm

SURVEY  
GULF OIL CORPORATION  
MADERA NO. 3 LOCATED AS SHOWN IN THE  
NW 1/4, NW 1/4, SEC. 8 T9N, R90W, 6TH PM.  
MOFFAT COUNTY, COLORADO.

DATE 8/12/60  
REFERENCES  
US GLO Township Plat  
Approved 1912  
FILE GULF