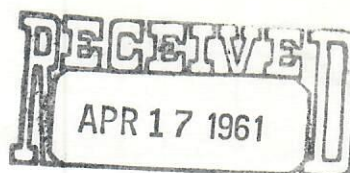


OIL AND GAS CONSERVATION COMMISSION  
OF THE STATE OF COLORADOOIL & GAS  
CONSERVATION COMMISSION

## NOTICE OF INTENTION TO DRILL

## INSTRUCTIONS:

A notice of intention to drill a well shall be filed in duplicate on all Federal and Patented lands, and in triplicate on all State lands. Do not begin operations until approved copy has been received. It is mandatory that the proposed location comply with all rules and regulations of the Commission. Locate well on section grid in proper location, and indicate extent of lease. Unless operations are commenced within 180 days after the date of approval hereof, this approval to drill will become null and void.

Name of Operator Plains Exploration Company Phone No. CH 4-7431  
Address 1135 Petroleum Club Bldg. City Denver 2 State Colorado


How is liability secured: Well Bond (Attached) ☐; Blanket Bond ☐; Waiver ☒  
(Check one)

Lease Name Orville H. Craig L-2794

Well No. 1

Field Name Wildcat ☒

County Morgan

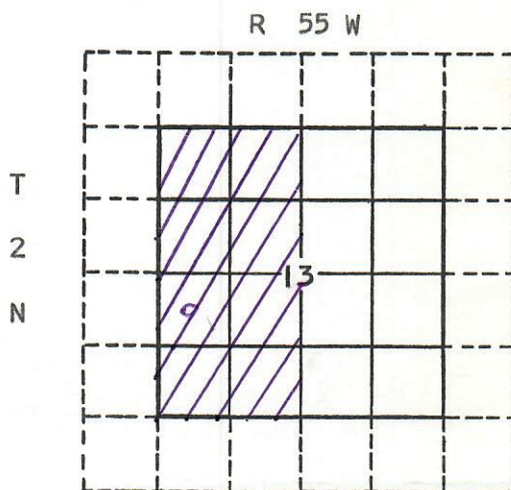

Location C NW SW Section 13 Township 2N Range 55W Meridian 6th P.M.  
(quarter quarter)  
1980 feet from N Section line and 660 feet from W Section Line  
N or S E or W

The well is located on: Patented land ☒ State land ☐ Federal land ☐

The well is located within a spaced area: Yes ☐ No ☒

Distance from proposed location to nearest property or lease line 660 feet.

Distance from proposed location to nearest drilling unit line 660 feet.

Objectives: "D" Sand Depth 4950'; "J" Sand Depth 5030'  
Formation Estimate Formation Estimate

Proposed length of surface casing 150 feet of 8-5/8" casing set w/125 sax cement.

## REMARKS:

Estimated Total Depth - 5,200'.

Ground elevation will be furnished when available.

Agent	
Bond	
Spot	
600 ft.	
1200 ft.	
Wells	
Oil	
Gas	
Status	

I/We hereby swear (or affirm) that the statements herein made are a full and correct report.

## APPROVED:

Date April 17, 1961

Director

Company Plains Exploration Company Date Apr. 14, 1961  
1135 Petroleum Club Bldg.

Address Denver 2, Colo. Phone No. CH 4-7431

By Russell H. Volk Title President  
Russell H. Volk Signature