




01093307


CERTIFICATE OF SURVEY
for
H.L. Hunt
Morgan County, Colorado

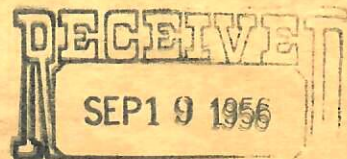

OIL & GAS
CONSERVATION COMMISSION

BEST IMAGE
AVAILABLE

T2N. R56W. 6 P.M.

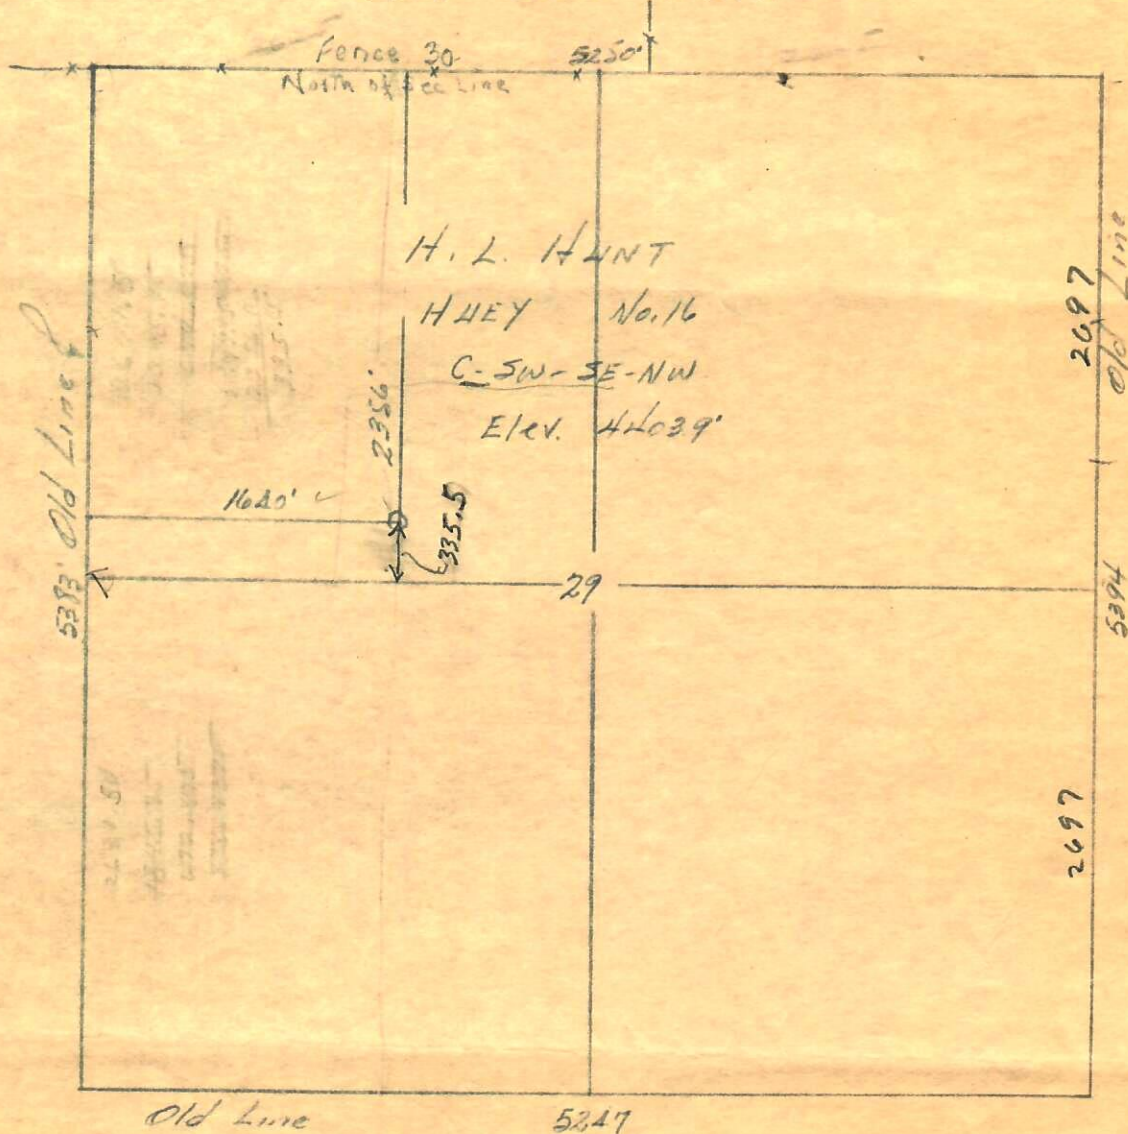

I hereby certify that the above plat is an accurate representation of a correct survey showing the location of H.L. Hunt Huey No. 16 Oilwell in C SW 1/4 SE 1/4 NW 1/4 Sec. 29 T2N R56W 6PM. The elevation of the ground at the stake is 4403.9 feet above sea level from U.S.B.R. Bench Mark.

Fort Morgan, Colorado
Sept. 15, 1956

Richard J. Robinson
Registered Professional Engineer
State of Colorado.