


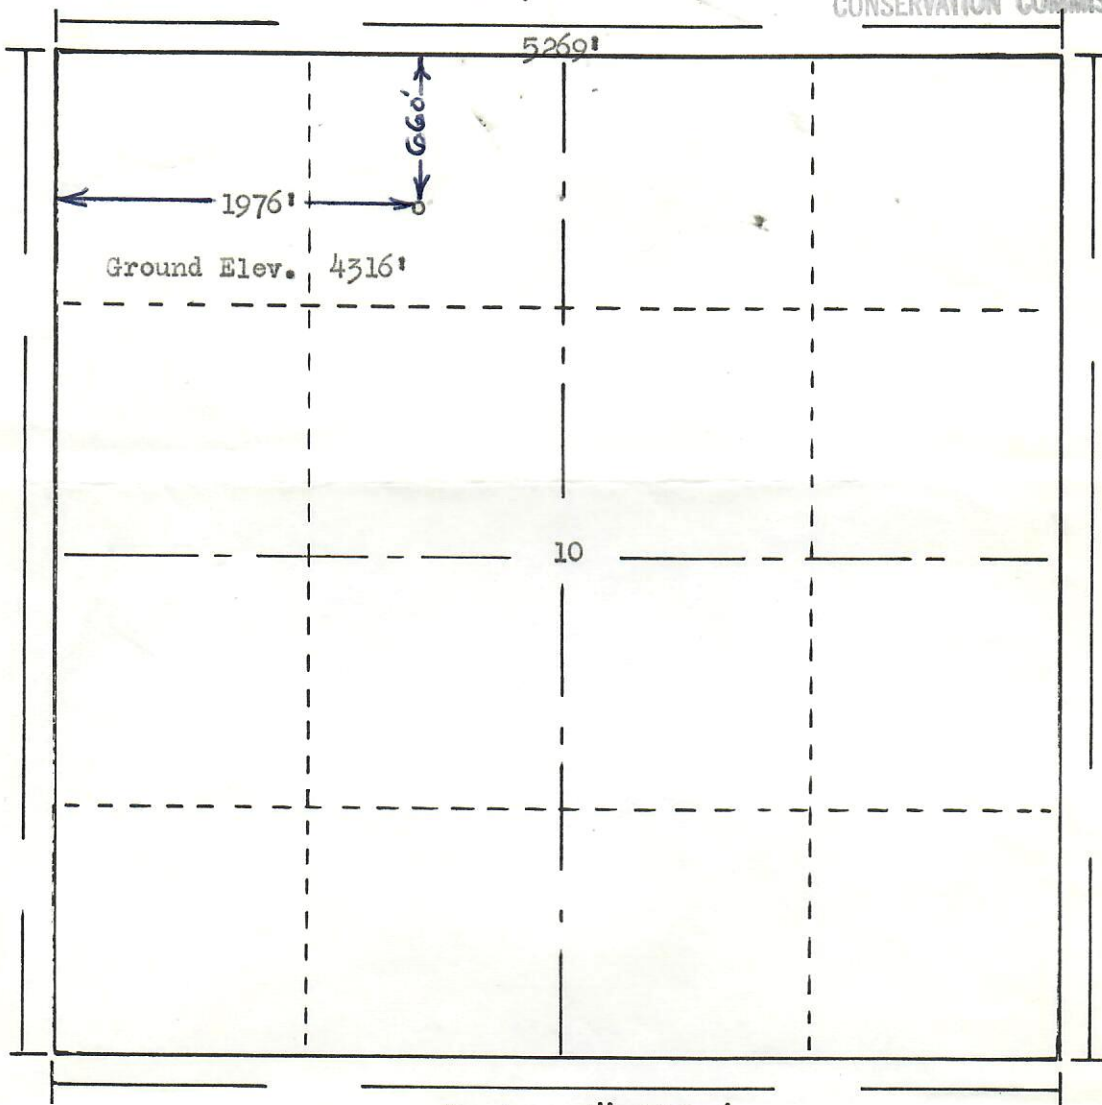

99999999

08705819

OIL & GAS
CONSERVATION COMMISSION

Scale ... 1" = 1000'

Powers Surveyors, Inc. of Denver, Colorado
has in accordance with a request from Mr. Allison
for Maverick Oil Company determined the
Location of No. 1 Peterson
to be CNE NW Section 10 Township 2N
Range 56W of the 6th Principal Meridian
Morgan County, Colorado

I hereby certify that this plat is an
accurate representation of a correct
survey showing the location of



00104804

Brian G. Holloway
Licensed Land Surveyor No. 2853
State of Colorado