


MONITORING WELL COMPLETION DIAGRAM

Project: MIT AOC – Stroh O 02-17
Location: Milliken, CO
Contractor:
Driller: Remington Technologies
Method: Hollow Stem Auger

Monitoring Well ID: MW-1
Drilling / Construction Date: 10/23/23

Protective Cover
Locking Cap

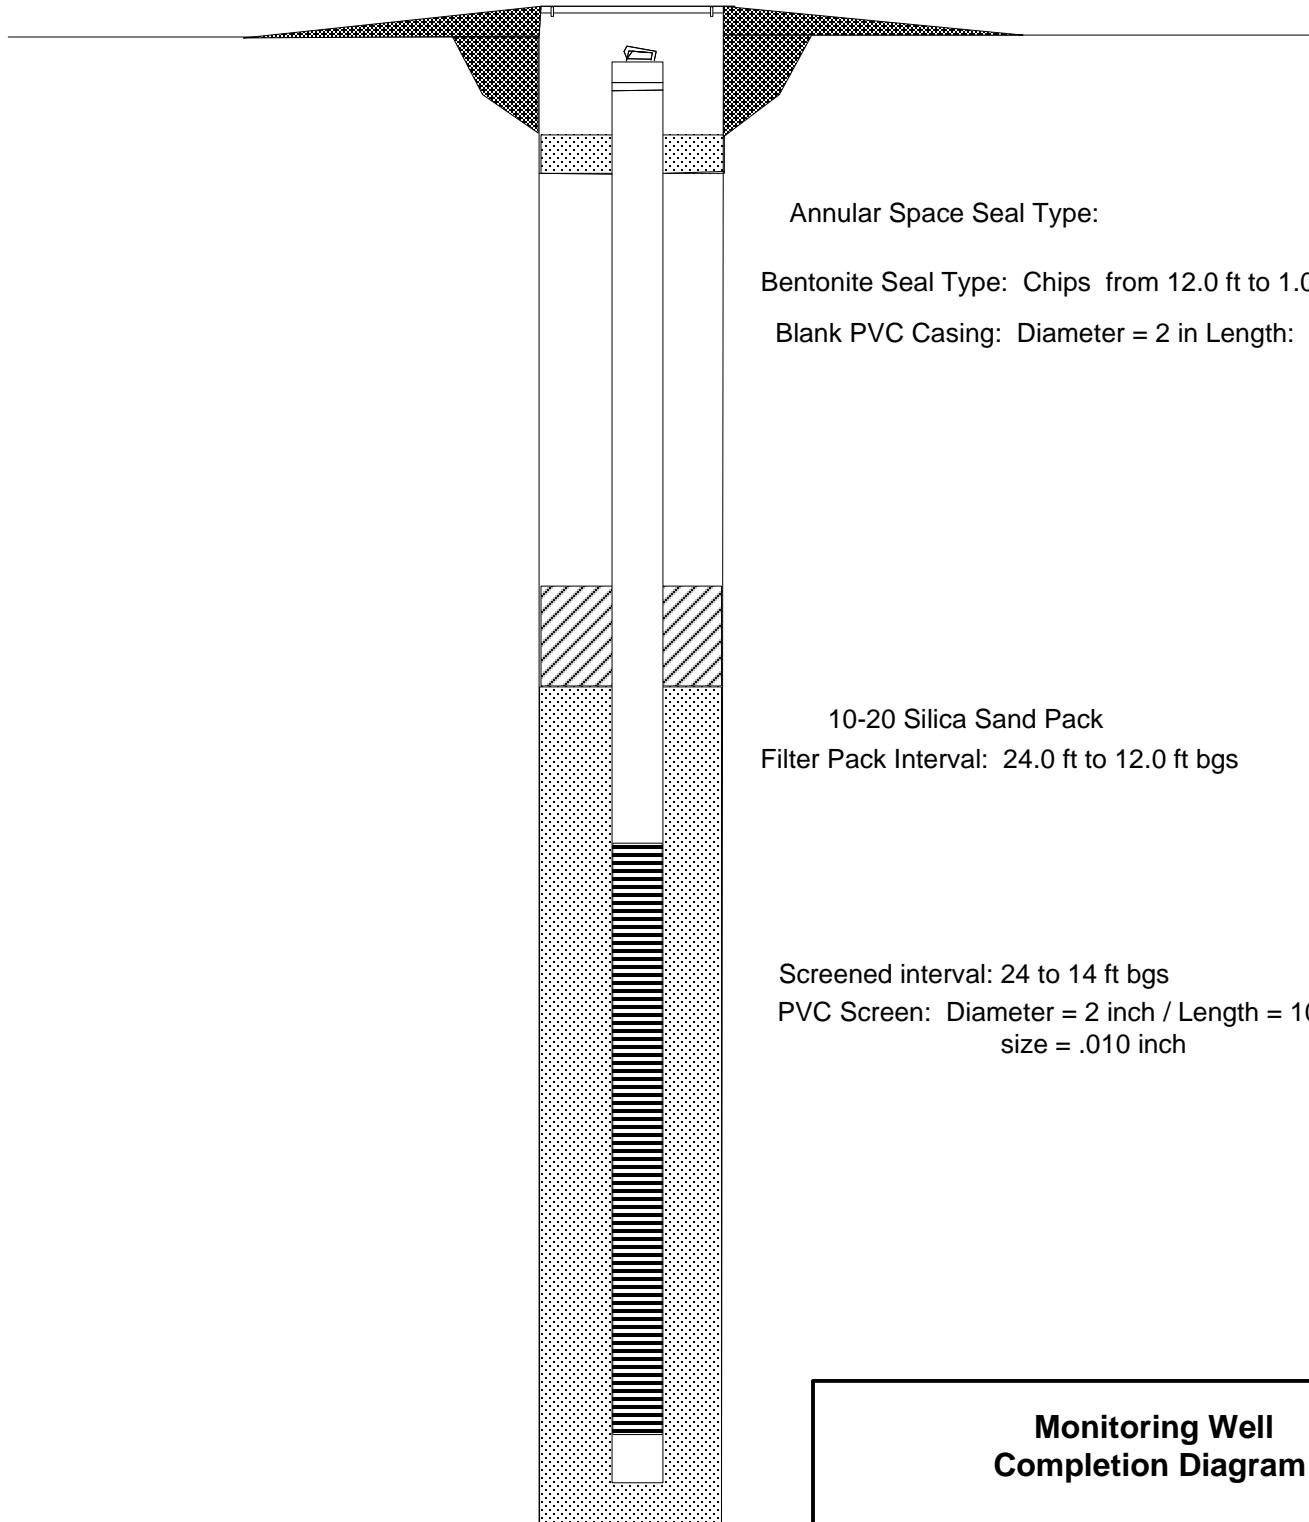

Total Depth = 24.0 ft

Monitoring Well Completion Diagram

Revision Date:	
Revision Number	
Revised by:	
Approved by:	
Project Number:	
Scale:	

olsson