

From: [Jenkins - DNR, Steve](#)
To: [Chris Ogonbonna](#)
Cc: [Adam Conry](#); [Derek Clark](#); [Randy Williams](#); [Trevin Frederiksen](#); [Michael Schwarz](#); [Regulatory](#)
Subject: Re: MCCOY 2-4-5 P&A | API: 05-123-24365
Date: Thursday, January 11, 2024 12:26:35 PM
Attachments: [image001.png](#)
[image002.png](#)

Chris et al:
You are approved as requested.
Thanks,
Steve

On Thu, Jan 11, 2024 at 10:20 AM Chris Ogonbonna <cogbonna@civiresources.com> wrote:

Good Morning Steve,

Sending over an update on this well, well is still at 0 psi with no LEL's detected after pumping the approved balance plug (tagged TOC at 2460). However, we are still seeing some bubbles from the well. We've also pressure tested the surface casing to rule out any leaks.

We'll be pumping another 200' in efforts to shut off the bubbles, from ~ 2460' to 2260'. We'll monitor tomorrow morning before proceeding any further with the P&A.

Please let me know if you have any questions,

Thanks,

Chris Ogonbonna

Production Engineer

cell: (720) 435 – 9250 | Direct: (303) 294 – 7877

650 Southgate Drive | Windsor, CO | 80550

www.civitasresources.com | NYSE: CIVI



From: Chris Ogonbonna

Sent: Tuesday, January 9, 2024 12:44 PM

To: Jenkins - DNR, Steve <steve.jenkins@state.co.us>

Cc: Adam Conry <aconry@civiresources.com>; Derek Clark <declark@civiresources.com>; Randy Williams <rwilliams@civiresources.com>; Trevin Frederiksen <tfrederiksen@civiresources.com>; Michael Schwarz <mschwarz@civiresources.com>; Regulatory <regulatory@civiresources.com>

Subject: RE: MCCOY 2-4-5 P&A | API: 05-123-24365

Perfect,

Thanks Steve.

From: Jenkins - DNR, Steve <steve.jenkins@state.co.us>

Sent: Tuesday, January 9, 2024 12:28 PM

To: Chris Ogbonna <cogbonna@civiresources.com>

Cc: Adam Conry <aconry@civiresources.com>; Derek Clark <declark@civiresources.com>; Randy Williams <rwilliams@civiresources.com>; Trevin Frederiksen <tfrederiksen@civiresources.com>; Michael Schwarz <mschwarz@civiresources.com>; Regulatory <regulatory@civiresources.com>

Subject: Re: MCCOY 2-4-5 P&A | API: 05-123-24365

Chris et al:

You are approved as requested.

Thanks,

Steve

On Tue, Jan 9, 2024 at 12:24 PM Chris Ogbonna <cogbonna@civiresources.com> wrote:

Afternoon Steve,

We're currently rigged up on the subject well (MCCOY 2-4-5 P&A | API: 05-123-24365) and have worked our way up to the stub – tagged at 2702'. Well had 0 psi this morning but we're seeing some bubbles while monitoring (no LEL's detected). We plan on pumping a 200' balance plug today before shutting down for the night. We'll monitor well tomorrow morning and confirm bubbles are gone before proceeding with the surface plug.

Please let me know if you have any concerns with that plan, attached the approved FM6 for your convenience,

Thanks,


Well Name: Mccoy 2-4-5

Reference Wells

Type	Comment
Fox Hills	246'
Water Well	490'
Pierre	1196'

Well Name Mccoy 2-4-5	API# 051232436500	Operator CRESTONE PEAK RESOURCES OPERATING LLC	State CO	County/Parish WELD
Quarter 1 NW	Quarter 2 SW	Section 5	Township 2	Township N/S Dir N
			Range 67	Range E/W Dir W

Vertical, Original Hole, 11/8/2023 3:16:55 PM

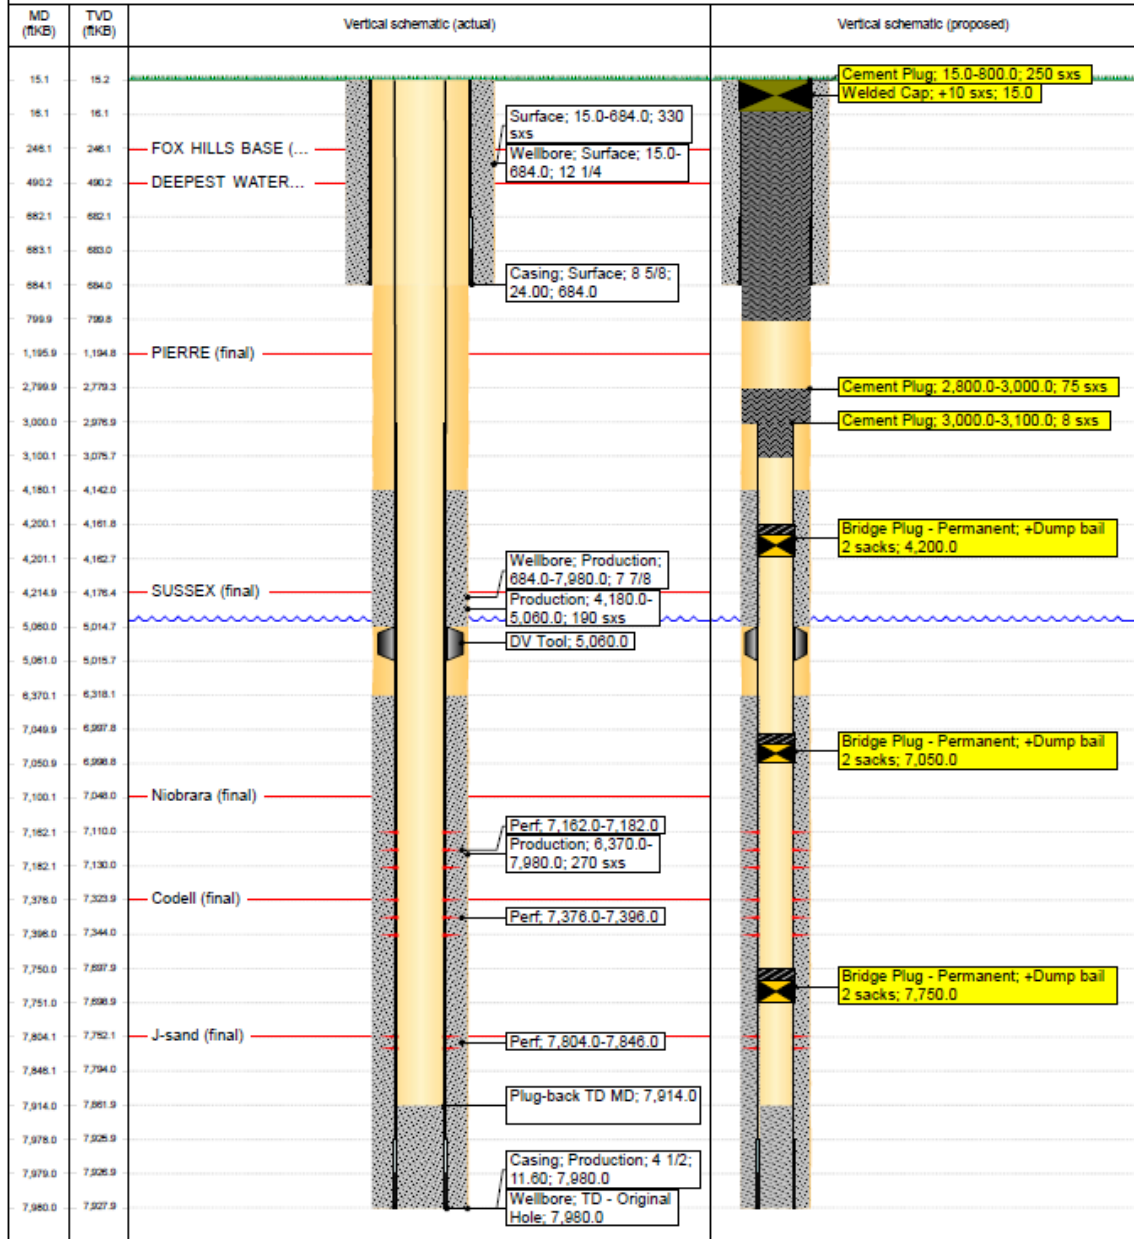

www.peloton.com

Page 1/1

Report Printed: 11/8/2023

Chris Ogonna

Production Engineer

Cell: (720) 435 - 9250 | Direct: (303) 294 - 7877

650 Southgate Drive | Windsor, CO | 80550

www.civitasresources.com | NYSE: CIVI



--

Stephen C. Jenkins, P.E., C.P.E.S.C.

North Central Area Engineer

C 720.846.8066 | F 303.894.2109
1120 Lincoln Street, Suite 801, Denver, CO 80203
Your_steve.jenkins@state.co.us | www.colorado.gov/ecmc

--

Stephen C. Jenkins, P.E., C.P.E.S.C.

North Central Area Engineer



C 720.846.8066 | F 303.894.2109
1120 Lincoln Street, Suite 801, Denver, CO 80203
Your_steve.jenkins@state.co.us | www.colorado.gov/ecmc