



FORM F-106



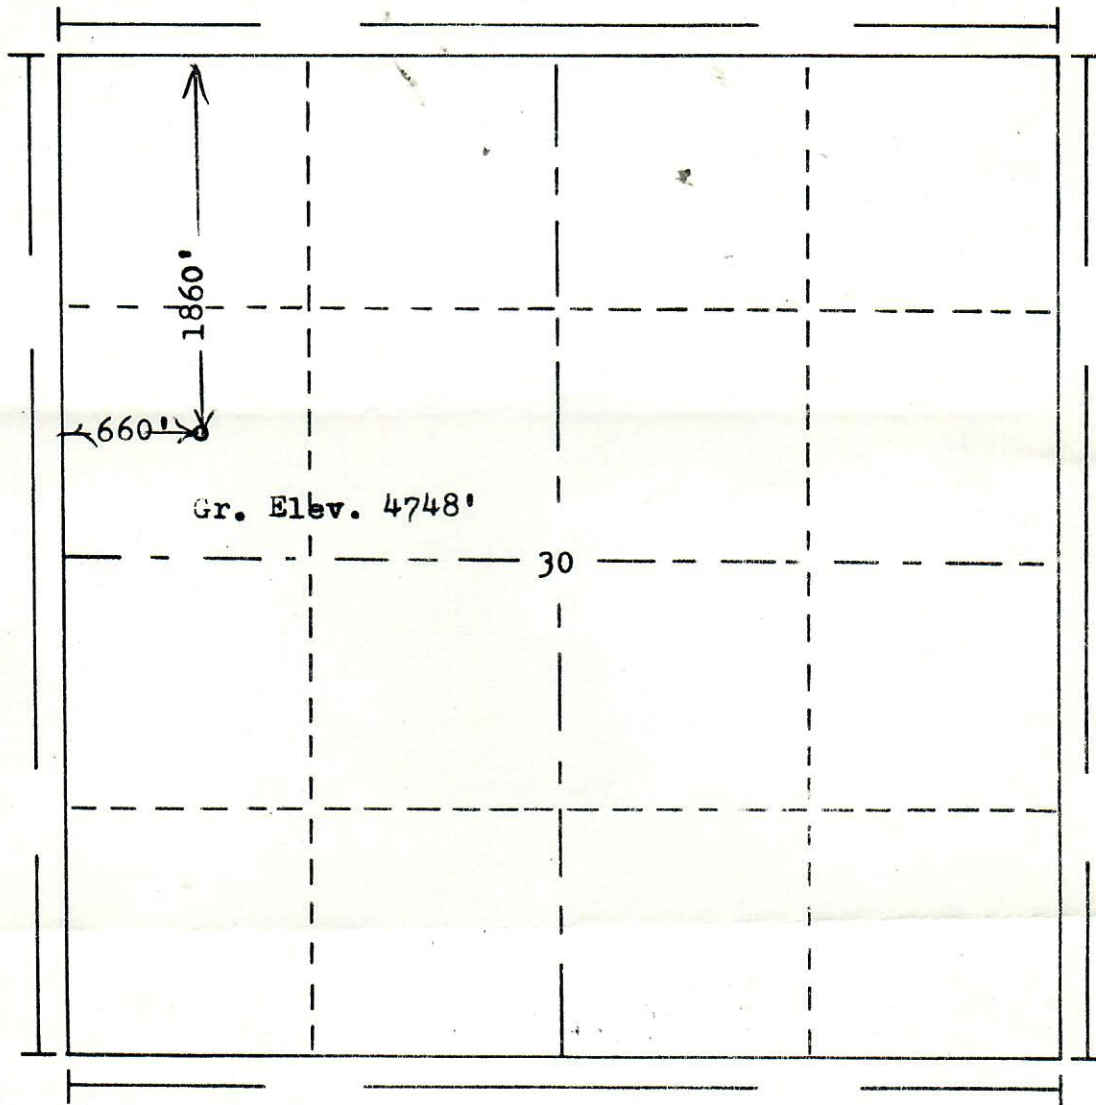
02358212

RECEIVED

APR 28 1981

COLO. OIL & GAS CONS. COMM.

R. 55W

T.
3
S

Scale... 1" = 1000'

Powers Elevation of Denver, Colorado

has in accordance with a request from Mr. Davis
for Keba Oil & Gas Co.

determined the location of No.20 West Fork Unit
to be 1860'FN & 660'FW

Section 30 Township 3S
Range 55W of the 6th Principal Meridian

Washington County, Colorado

I hereby certify that this plat is an
accurate representation of a correct
survey showing the location of

Date: 4-20-81

Billy L. Hooten
Licensed Land Surveyor No. 2853
State of Colorado