




99999999

121-07670

RECEIVED
DEC-7 1965

R. 54W

OIL & GAS
CONSERVATION COMMISSION

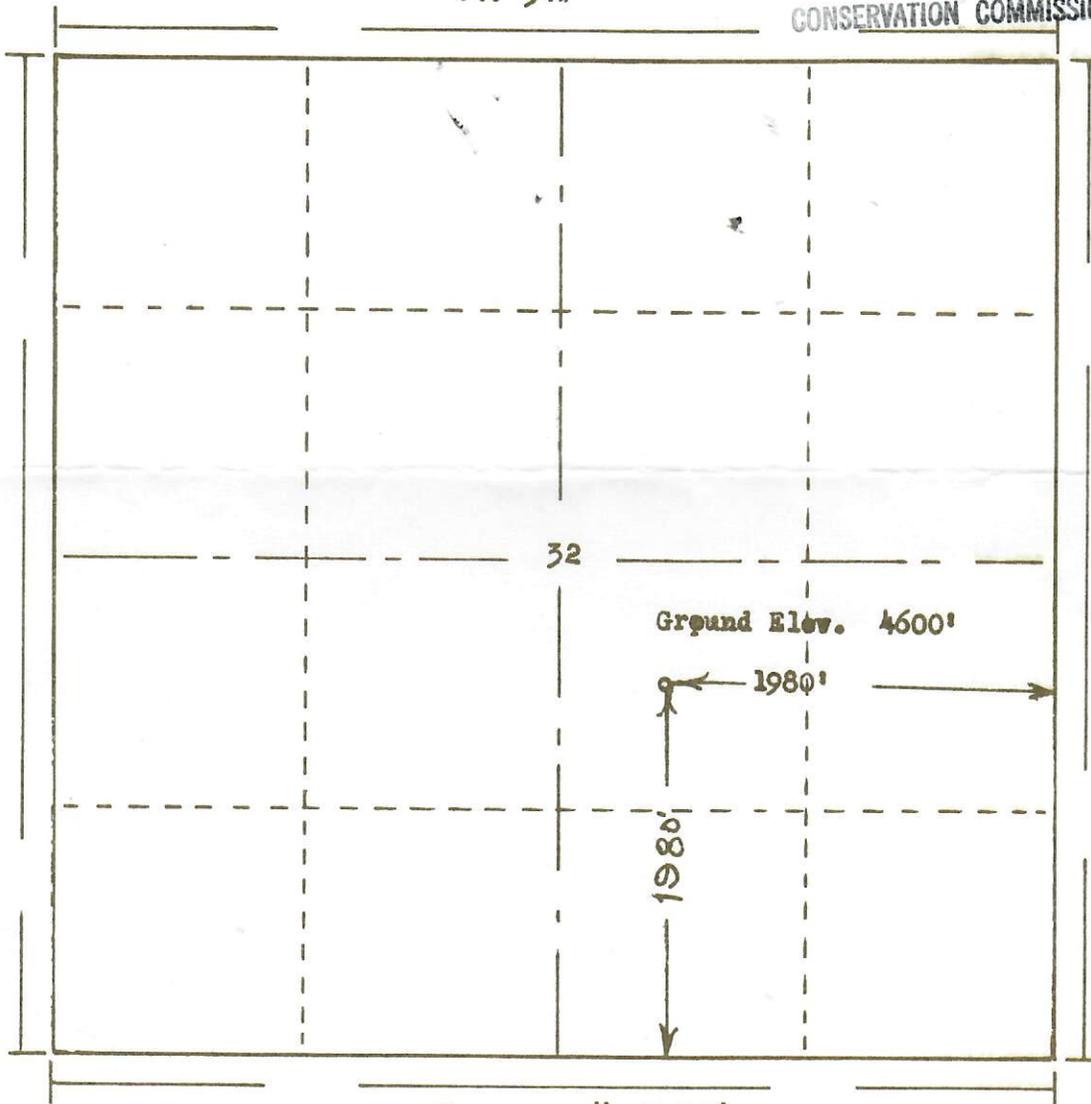

T.
2
N

Scale ... 1" = 1000'

Powers Surveyors, Inc. of Denver, Colorado
 has in accordance with a request from Mrs. Meyer
 for Plains Exploration Co. determined the
 Location of No. 1 Tittle
 to be CNW SE Section 32 Township 2N
 Range 54W of the 6th Principal Meridian
 Washington County, Colorado



00599944

65 517

I hereby certify that this plat is an
accurate representation of a correct
survey showing the location of

Date: 12-2-65

Clayton G. Hollman
 Licensed Land Surveyor No. 2873
 State of Colorado