



00054587

CERTIFICATE OF SURVEY  
for  
Chaparral Oil Co.  
Washington County, Colorado


RECEIVED

NOV 30 1970

COLO. OIL &amp; GAS COM.

T2N R54W 6PM.

N89°53'W 52945'

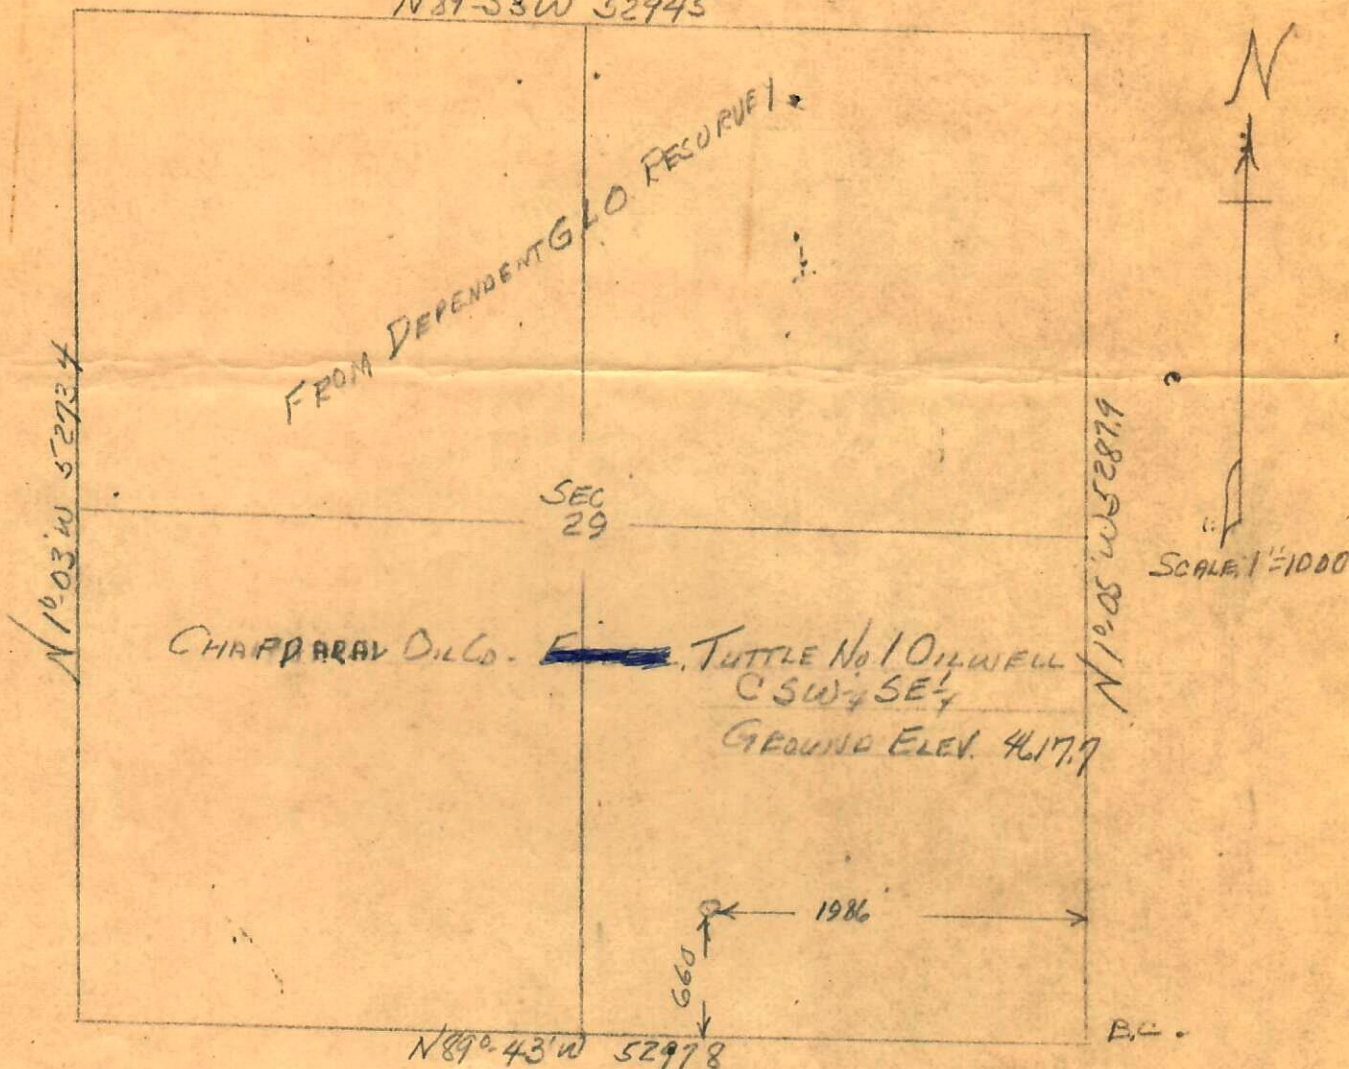

I hereby certify that the above plat is an accurate representation of a correct survey showing the location of Chaparral Oil Co. - , Tuttle No. 1 Oilwell in C SW 1/4 SE 1/4 Sec. 29 T2N R54W 6PM. The elevation of the ground at the stake is 4617.7 feet above sea level from U.S.C.&G. Bench Mark.

Fort Morgan, Colorado  
March 16, 1969

*Leslie J. Osborne*  
Registered Professional Engineer  
State of Colorado