

121-07047




99999999

RESIDENCE PHONE EMPIRE 6-6104

EDWIN F. MARKER
GEOLOGIST
321 COLORADO BUILDING
DENVER 2, COLORADO

August 15, 1964

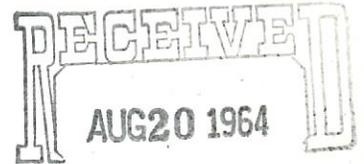

OIL & GAS
CONSERVATION COMMISSION
OFFICE PHONE AMHERST 6-0774

Mr. Leon Oliver, Jr.
W. G. Rogers
3707 Rawlins
Oak Plaza Building
Dallas 19, Texas

Dear Mr. Oliver:

The following report covers the W. G. Rogers-#B-1 Warren,
C SW NW Section 12, Township 2 North, Range 49 West,
Washington County, Colorado.

The subject test was drilled to total depth of 3976 feet,
approximately 52 feet below the top of the 'J' sand. A
core was cut in the 'D' sand from 3834 to 3872 feet. Good
oil-stained sand was recovered from 3852 to 3860 and 3861
to 3871 feet. Above oil shows tested water on drill stem
tests.

No showings of oil or gas were observed in the 'J' sand.

Very truly yours,

Edwin F. Marker




00053932

CERTIFICATE OF SURVEY
for
W.G. Rogers Inc.
Washington County, Colorado

RECEIVED
AUG-5 1964

OIL & GAS
CONSERVATION COMMISSION

T2N R49W 6PM

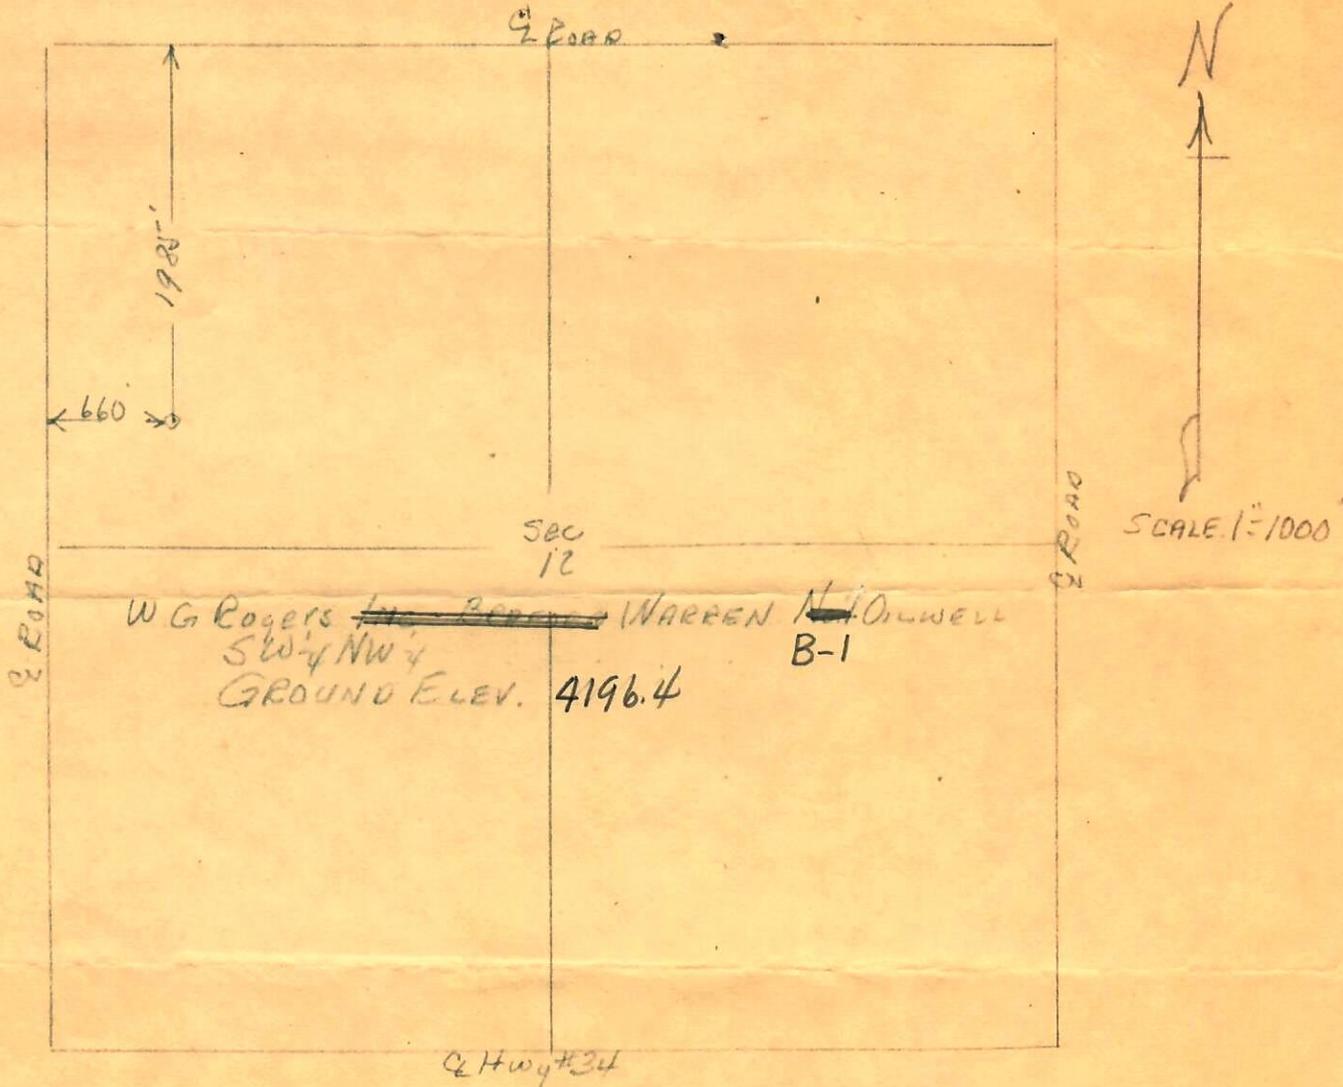

I hereby certify that the above plat is an accurate representation of a correct survey showing the location of W.G. Rogers ~~Inc.~~ ~~Warren N Oilwell~~ Oilwell in SW 1/4 NW 1/4 Sec. 12 T2N R49W 6PM. The elevation of the ground at the stake is 4196.4 feet above sea level from U.S.C.&G. Bench Mark.

Fort Morgan, Colorado
July 28, 1964

Levil Osborne
Registered Professional Engineer
State of Colorado

Warren B-1