


CERTIFICATE OF SURVEY  
for  
H.L.Hunt


Morgan County, Colorado

T2N R56W 6PM

5250 Fence

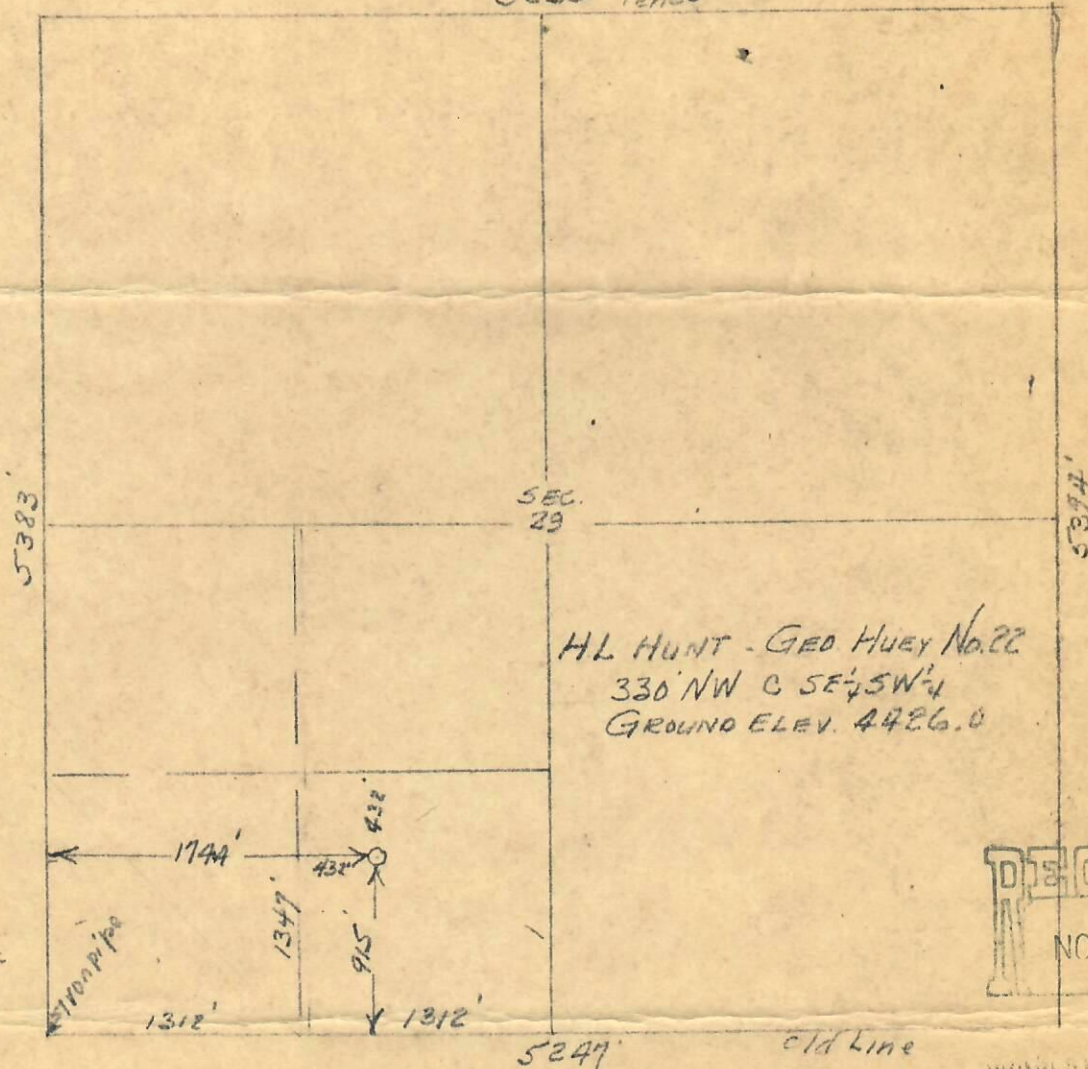

SCALE: 1"=1000'

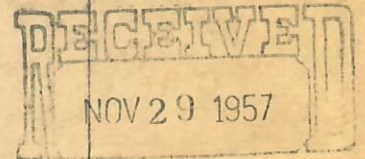

I hereby certify that the above plat is an accurate representation of a correct survey showing the location of H.L.Hunt -Geo. Huey No. 22 Oilwell 330 feet Northwest of Center Sec.29 SE 1/4 SW 1/4 Sec. 29 T2N R56W 6PM. The elevation of the ground at the stake is 4426.0 feet above sea level from U.S.B.R. Bench Mark.

Fort Morgan, Colorado  
Nov. 14, 1957.

*Lacey Osborne*  
Registered Professional Engineer  
State of Colorado.



00104954

