


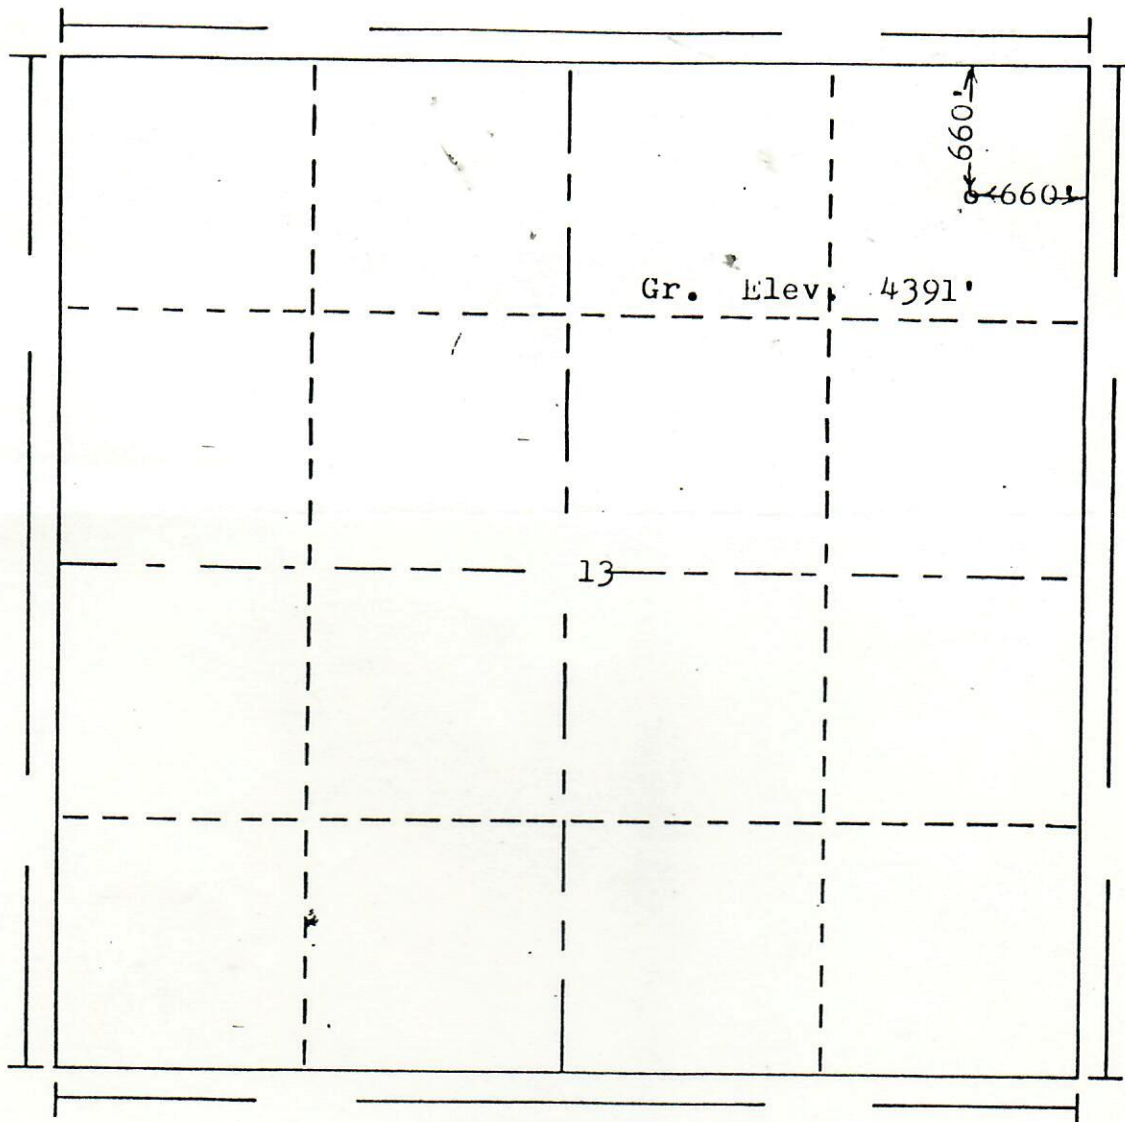

01072738

R. 58W

T.
2
N

Scale... 1" = 1000'

Powers Elevation of Denver, Colorado

has in accordance with a request from Mr. Ashby
for Lynx Exploration Co.

determined the location of No. 1 Dude
to be CNR NE Section 13 Township 2N
Range 58W of the 6th Principal Meridian
Morgan County, Colorado

I hereby certify that this plat is an
accurate representation of a correct
survey showing the location of

Date 12-14-84

B. J. H. H. H.
Licensed Land Surveyor No. 2853
State of Colorado

