

Apex Oil Ventures

8823 So Redwood Rd Suite D-1

Nest Jordan Ut. 84088

Not To Scale

WELL: P.R-TRIGOOD (Gillam) 600' No. 10


API: 05-103-06007

LOCATION: NWSE, Sec 4, T1N. R10W, RIO BLANCO Co

Well spudded 10/11/1964

TD 3,890 ft 10/21/1964

WELL BORE DIAGRAM

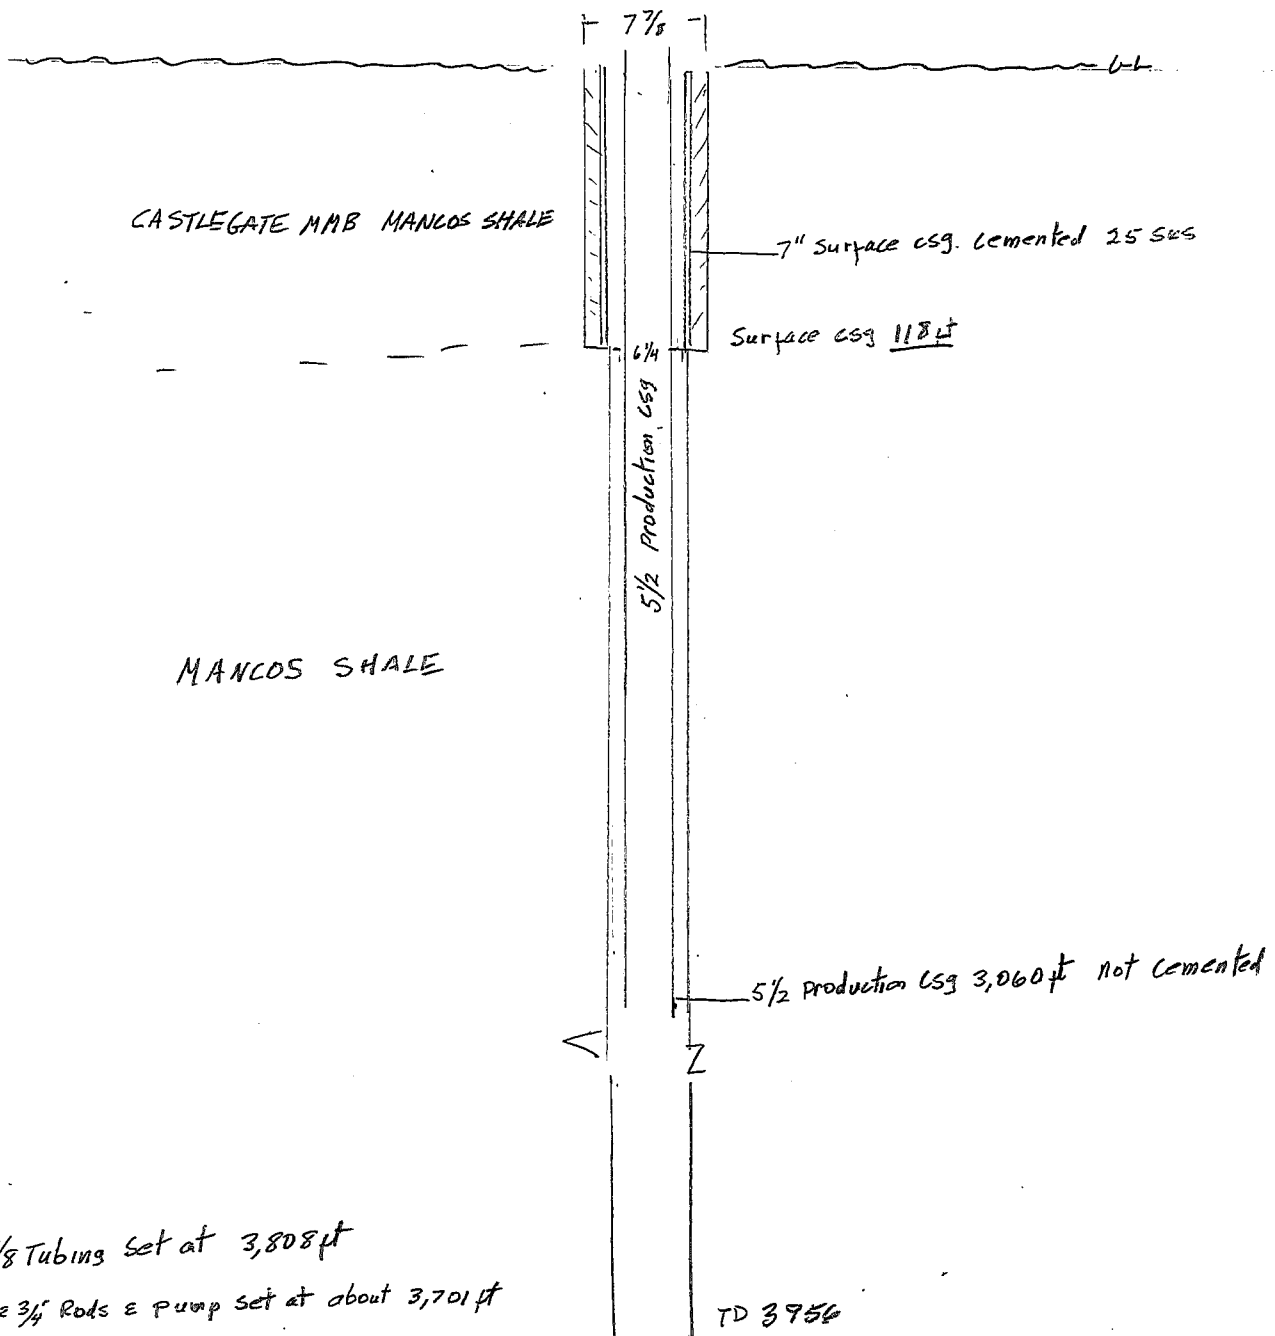

2 7/8 Tubing set at 3,808 ft

7/8 & 3/4 Rods & Pump set at about 3,701 ft