


WELL NAME:	PROSPER FARMS 04-65 02-01-06 02AH				OPERATOR:	CRESTONE PEAK RESOURCES	
FIELD:	DJ HORIZONTAL NIOBRARA				FORMATION:	Niobrara	
SHL:	qtr-qtr	NWSW	Section 2	Township	4S	Range	65W
BHL:	qtr-qtr	SENE	Section 6	Township	4S	Range	64W
COUNTY:	ARAPAHOE		STATE:	CO		API:	05-005-07517

not to scale	
GROUND LEVEL:	5631
KELLY BUSHING:	5656
SPUD DATE:	1/29/2023
TD DATE:	3/20/2023

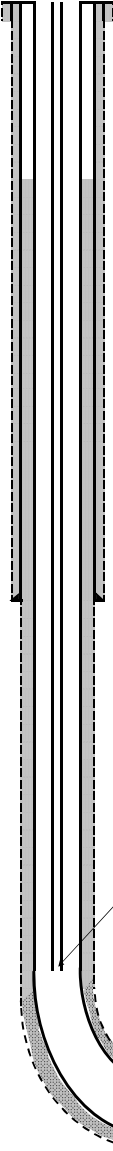

CONDUCTOR CASING	
SIZE:	16
WEIGHT:	37#
HOLE SIZE:	26"
CSG DEPTH:	114
CEMENT:	100 SKS
TOC:	SURFACE

SURFACE CASING	
SIZE:	9 5/8"
WEIGHT:	36#
HOLE SIZE:	13 1/2"
HOLE DEPTH:	3,588
CSG DEPTH:	3,588
CEMENT:	1478 SKS
TOC:	SURFACE

PRODUCTION CASING	
SIZE:	5 1/2"
WEIGHT:	20#
HOLE SIZE:	8 1/2"
TOTAL DEPTH TVD	7,652
TOTAL DEPTH MD	23,941
CSG DEPTH:	23,918
CEMENT:	3285 SKS
TOC:	1,060

PRODUCTION TUBING	
SIZE:	2 3/8"
WEIGHT:	4.7#
DEPTH:	8,189
PACKER DEPTH:	8,188

EOT @ 8189

FORMATION TOPS & PERFORATIONS		
NIOBRARA MD	8,173	
<hr/>		
PERFORATIONS	8,800	23,865
<hr/>		

FRAC DATA	
698,582	BBLS GELLED FLUID
6,667	BBLS ACID
46,414	BBLS FRESH WATER
751,663	BBLS TOTAL FLUID

0	# 30/50 MESH
6,707,494	# 40/70 MESH
10,773,773	# 100 MESH
17,481,267	# TOTAL SAND
93	STAGES

Production Csg @ 23918'

MD TD 23,941