 


Flowline Abandonment Type:

 
 
 
Full Removal

Note: With full removal of LEONARD C21-16 (05-123-26188).

Flowlines

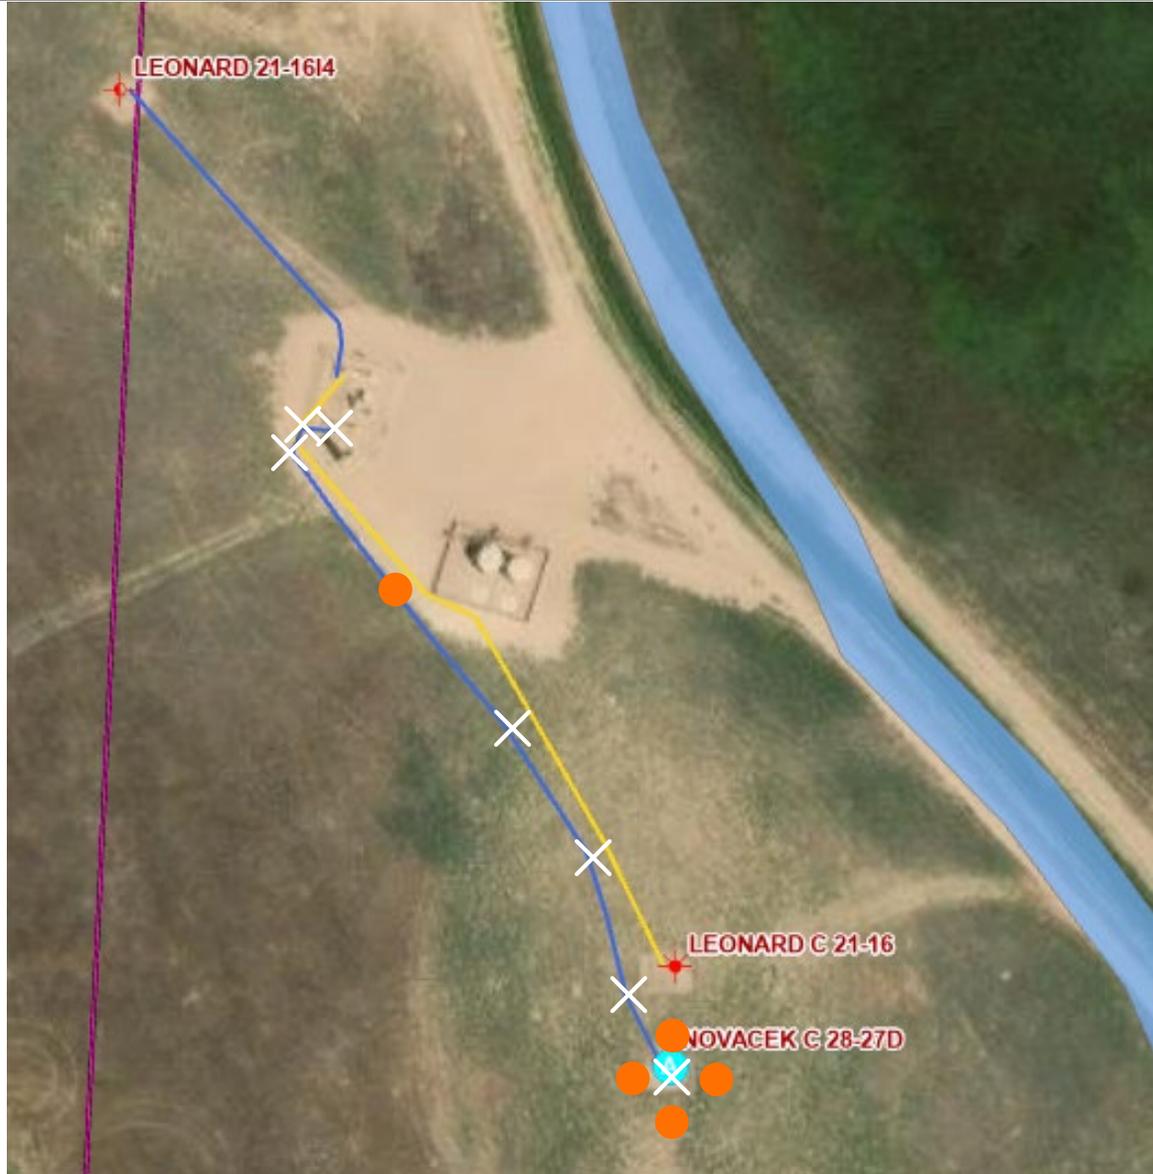
-  Abandoned
-  Active
-  Out of Service
-  Pre-commissioned
-  Removed
-  Turned into Air Line
-  Area of Conflict
(Proposed Abandon-in-Place Area)
-  Proposed Soil Sample Location
-  Field Screening Location

Wells

-  Active
-  Abandoned Location
-  Dry & Abandoned
-  Plugged & Abandoned
-  Producing
-  Shut-In
-  Temporarily Abandoned

Third-Party Pipelines

- 
- 
- 
- 
- 
- 
- 
-  NWI Wetlands



Well Latitude/Longitude: 40.292230/-104.549400

Flowline Length (ft): 382

Flowline Point A Latitude/Longitude: 40.29221329/-104.5494008

Flowline Point B Latitude/Longitude: 40.29306803/-104.5499824

Created By: Clara Jenck
Date: 02/13/2024

