Red Rocks 1-16
Location ID 484358

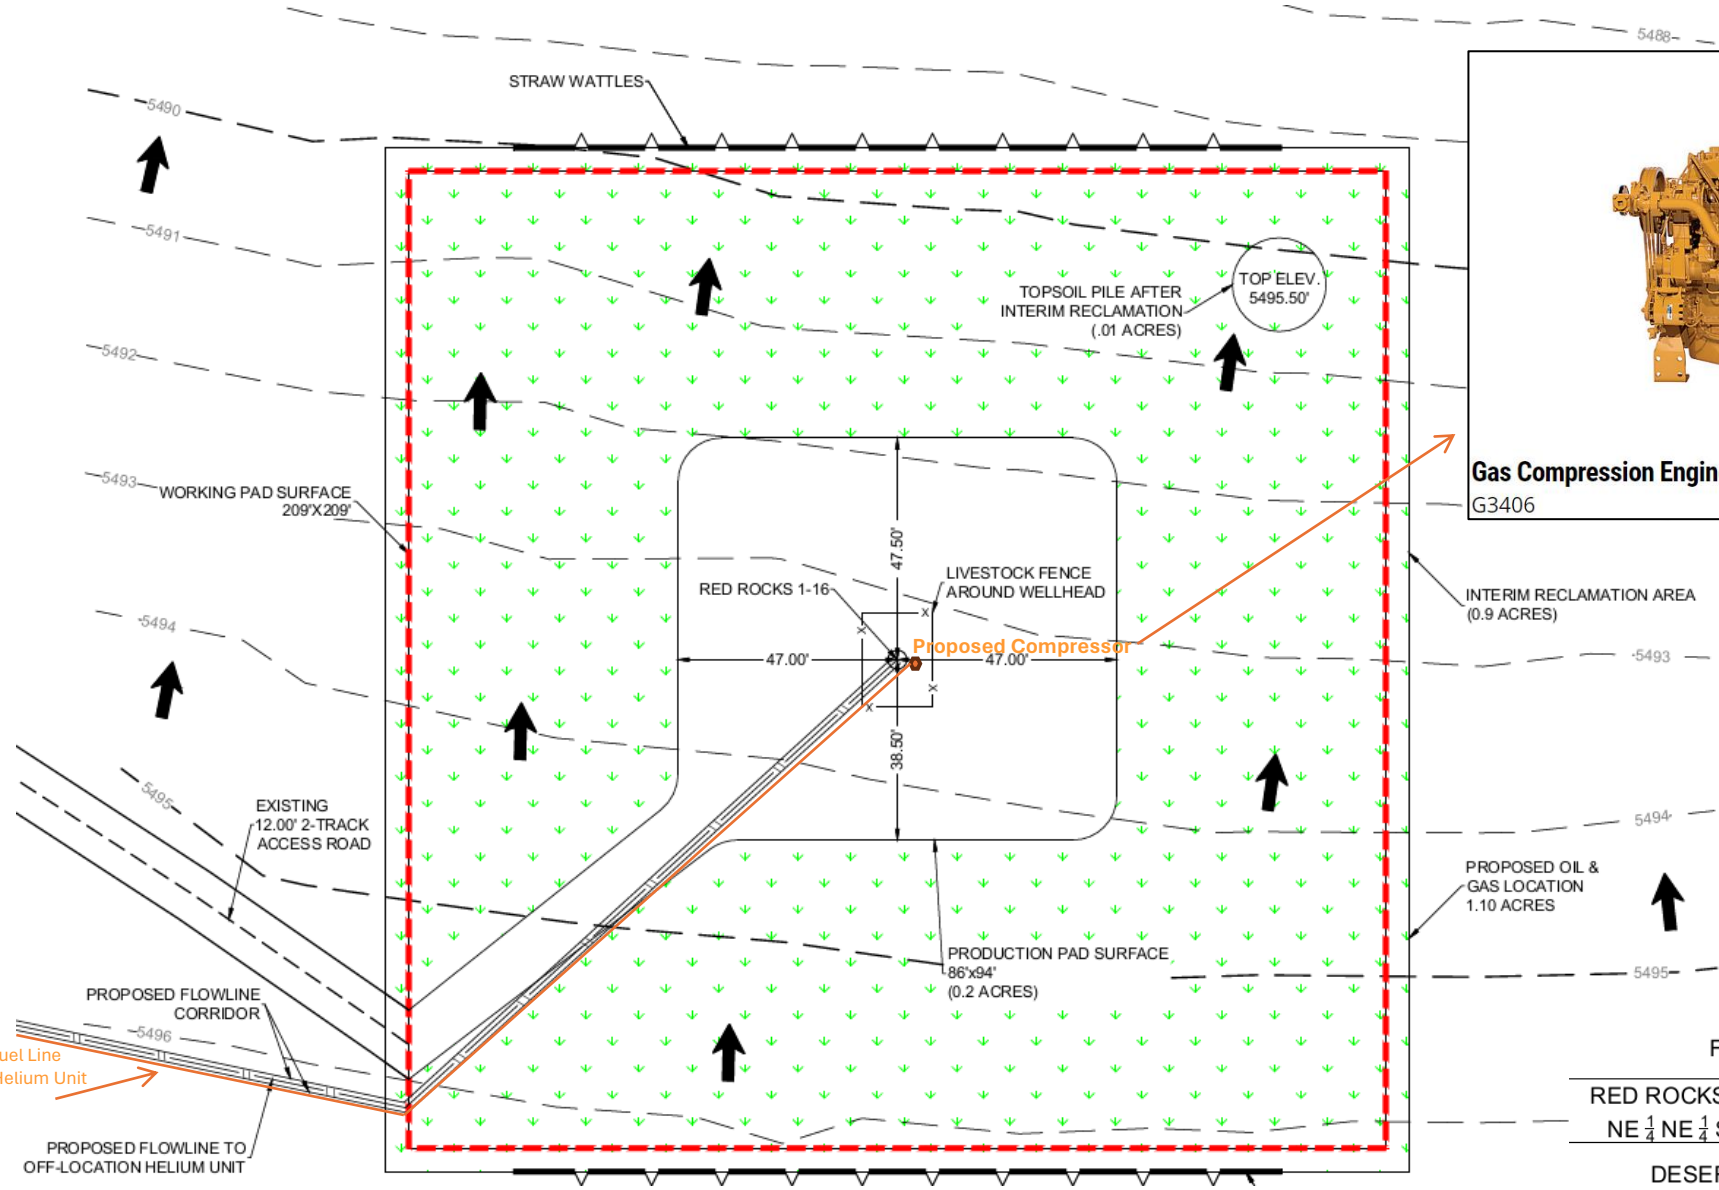

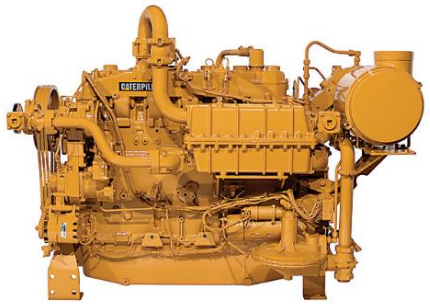

Gas Compression Engines
G3406

Manufacturer dBA:

Ft	dBA
5	109
23	96
49	89

Agricultural designation at Table 423-1 met approximately 100' from edge of Production Pad.

Nearest RBU 5,280'+ S
Public Road 5,150' W

FACILITY LAYOUT

RED ROCKS 1-16 LAS ANIMAS COUNTY
NE $\frac{1}{4}$ NE $\frac{1}{4}$ SEC. 1 T30S R55W 6TH P.M.

DESERT EAGLE OPERATING