



00095000

CERTIFICATE OF SURVEY


for

Kimbark Exploration Co., Patrick A. Doheny
Washington County, Colorado

JUN-8 1965

OIL & GAS
CONSERVATION COMMISSION

T2N R54W 6PM

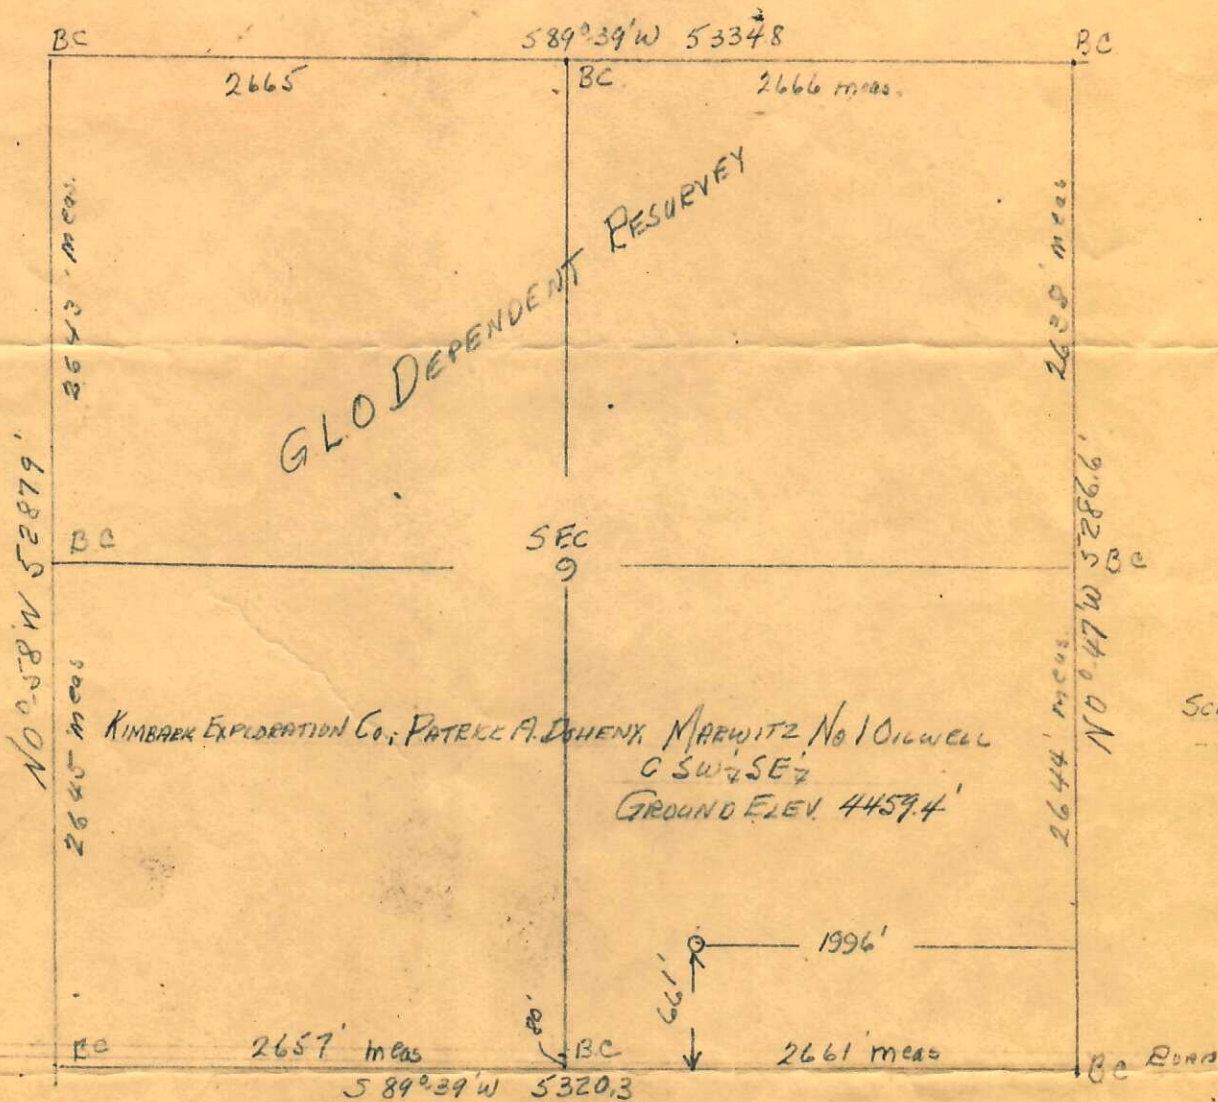

I hereby certify that the above plat is an accurate representation of a correct survey showing the location of Kimbark Exploration Co., Patrick A. Doheny-Marwitz No. 1 Oilwell in C SW 1/4 SE 1/4 Sec. 9 T2N R54W 6PM. The elevation of the ground at the stake is 4459.4 feet above sea level from U.S.C. & G. Bench Mark.

Fort Morgan, Colorado
June 3, 1965
Registered Professional Engineer
State of Colorado