



00054310

66 492

OIL AND GAS CONSERVATION COMMISSION OF THE STATE OF COLORADO

NOTICE OF INTENTION TO DRILL

RECEIVED ✓

DEC 1 - 1966

COLO. OIL & GAS CONS. COMM.


INSTRUCTIONS:

A notice of intention to drill a well shall be filed in duplicate on all Federal and Patented lands, and in triplicate on all State lands. Do not begin operations until approved copy has been received. It is mandatory that the proposed location comply with all rules and regulations of the Commission. Locate well on section grid in proper location, and indicate extent of lease. Unless operations are commenced within 180 days after the date of approval hereof, this approval to drill will become null and void.

Name of Operator SAMUEL GARY Phone No. 222-0744 Address 1700 Broadway, Room 506 City Denver State Colorado

How is liability secured: Well Bond (Attached) []; Blanket Bond []; Waiver [x] (Check one)

Lease Name Miller et al Well No. 9-1 Field Name Buffalo Wildcat [x] County Washington [x]

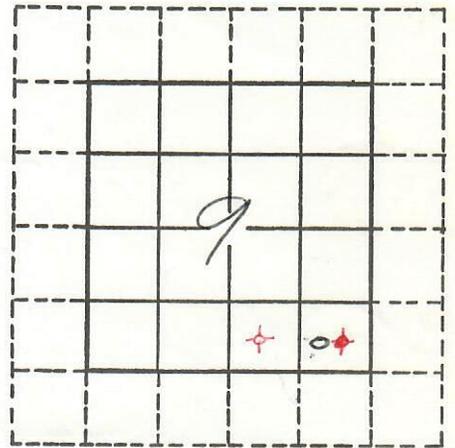

Location SE SE (quarter quarter) Section 9 Township 2N Range 54W Meridian 6th 661 feet from S Section line and 725 feet from E Section Line N or S E or W

The well is located on: Patented land [x] State land [] Federal land []

The well is located within a spaced area: Yes [] No [x]

Distance from proposed location to nearest property or lease line 661 feet. Distance from proposed location to nearest drilling unit line 3365 feet.

Objectives: "J" Formation Depth 4900 Estimate; Formation Depth Estimate

Proposed length of surface casing 110 feet.

REMARKS:

Table with 2 columns and 7 rows. Row 1: waived fee att - DVR. Row 2: WRS. Row 3: HMM. Row 4: JAM. Row 5: FRP. Row 6: JED Potted 12/1/66. Row 7: FILE.

I/We hereby swear (or affirm) that the statements herein made are a full and correct report.

APPROVED: Date DEC 1 1966 [Signature] Director

Company SAMUEL GARY Date 11-30-66 Address 1700 Broadway Phone No. By [Signature] Signature Title

66 492