



00066687

RECEIVED

AUG 7 1984


West Trail Exploration Co. and Gear Drilling Co.


Dyar #1

600' FWL of SE $\frac{1}{4}$, 890' FSL of SE $\frac{1}{4}$ (Approx. SW SE)

Section 13- T2N-R54W

Washington County, Colorado

Estimated ground elevation 4538'

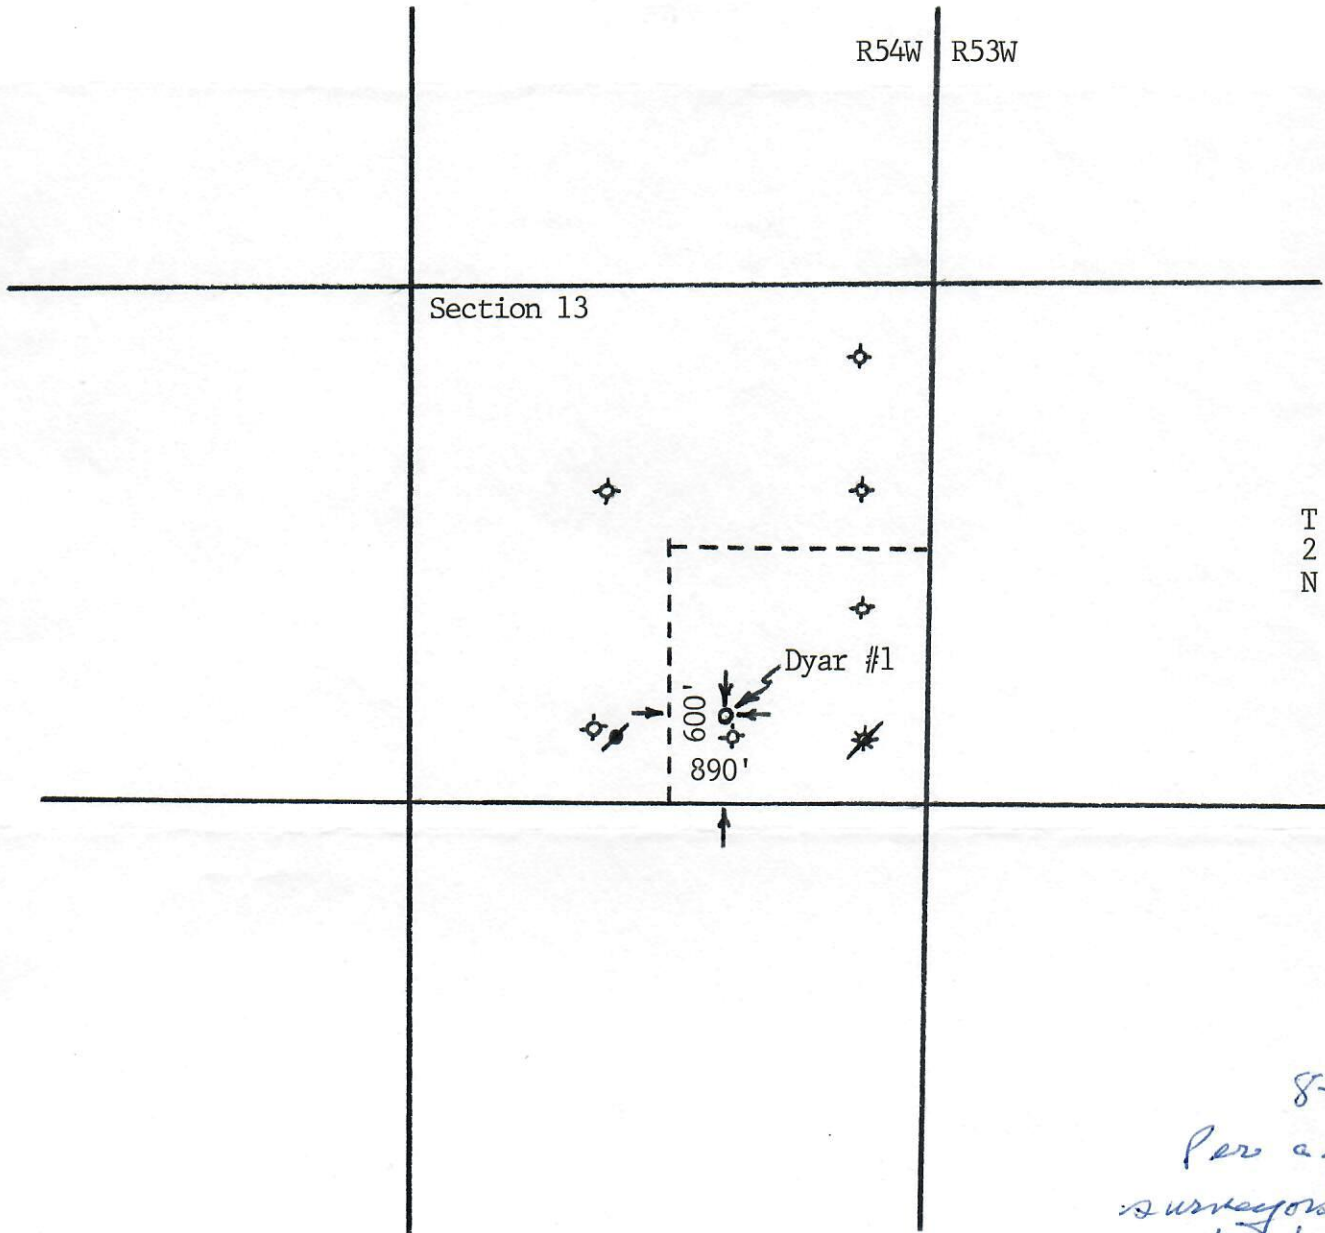

8-14-84
Per call,
surveyor's plat
coming in.
Jim