

COLORADO OIL AND GAS CONSERVATION COMMISSION
 SUNDRY NOTICES AND REPORTS OF WELLS


RECEIVED
 DEC 2 1955

OIL & GAS
 CONSERVATION COMMISSION

(Indicate nature of data by checking below)

- Notice of intention to drill (attach plat) X
- Notice of intention to change plans _____
- Notice of date for test of water shut-off _____
- Report on result of test of water shut-off _____
- Notice of intention to re-drill or repair well _____
- Notice of intention to clean out well _____
- Statement of shooting _____
- Statement of perforating _____
- Notice to pull or otherwise alter casing _____
- Notice of intention to abandon well _____
- Report of work done on well since previous report _____

Locate Well Correctly

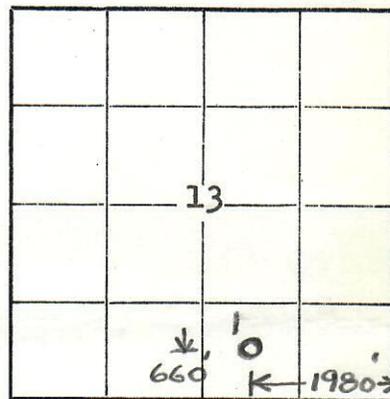

Notice to do work Land: Fee and Patented
 Report of work done State _____ Lease No. _____
Colorado
~~Washington~~ Washington Xenia
 State County Field

1 Rodemeister SE 1/4 13 2N 5/4W 6th PM
 (Well No.) (Lease) (1/4 Sec.) (Sec.) (Twp.) (Range) (Meridian)

The Well is located 660' Ft. (N) of Section Line and 1980' Ft. (E) of Section Line.
 (S) (W)

The elevation above sea level is 4550' Ft. (Estimated)

Details of Plan of Work: (State names of and expected depths to objective sands. Show sizes, weights, and length of proposed casings; indicate mudding jobs, cementing points, and all other important proposed work.)

10 3/4" Surface Casing - 150' (Estimated)
5 1/2" Completion string - 4900' (" ")

Objective Horizons (Cretaceous Age)
 "D" sand 4750' (Estimated)
 "J" sand 4840' (" ")

AJJ	
DYR	
FJK	
WRS	
HMM	
AH	
JJD	<input checked="" type="checkbox"/>
FILE	

Approved: DEC 2 1955

[Signature]
 Director

Date December 1, 1955

Company UTAH SOUTHERN OIL COMPANY
 Address 901 Utah Oil Building
Salt Lake City, Utah

By [Signature]
 P. L. Keller
 Title Representative-Denver Basin

Submit reports of proposed work, for approval, on this form in Duplicate for patented lands and in Triplicate for school and state lands.